

MISSISSIPPI DEPARTMENT OF NATURAL RESOURCES
Bureau of Land and Water Resources

P.O. Box 10631

Jackson, Mississippi 39209

WATER WELL DRILLERS LOG

COUNTY WELL LOCATED Jackson	
WELL NUMBER 2261	CODED
DATE WELL COMPLETED MAY 17, 1988	

PERMIT NUMBER 0239
NAME OF DRILLING FIRM Mechell Pump & Wells

NAME & MAILING ADDRESS OF LANDOWNER JAMES PEEL 12604 GARVE RD OCEAN SPRINGS O.S. MS.			
WELL LOCATION:	SEC	TOWNSHIP	RANGE
	9	6 N	9 E
DISTANCE	DIRECTION	NEAREST TOWN	
8 Miles	north	of O.S.	
OTHER LANDMARK			
WELL PURPOSE: <input checked="" type="checkbox"/> Home, <input type="checkbox"/> Irrigation, <input type="checkbox"/> Municipal, <input type="checkbox"/> Industrial, <input type="checkbox"/> Fish Pond, etc.			

PUMP DATA		
PUMP TYPE (Circle One): Submersible, Turbine, <input checked="" type="radio"/> Jet, Flowing Well, Other (Describe) _____		
POWER TYPE (Circle One): <input checked="" type="radio"/> Electric, <input type="radio"/> Tractor, <input type="radio"/> Diesel, <input type="radio"/> Gasoline, <input type="radio"/> Butane, Other (Describe) _____		
Pump Capacity (GPM) 13	No. of Stages 2	Setting Depth 60' FT.
PUMP TEST		
Well yielded 11 GPM with a drawdown of 10 ft. after 1 hours of pumping		

WELL DATA		
Well Depth 500'	Casing Diameter (In.) 2"	Casing Length (Ft.) 480'
Type of Casing PVC	Hole Depth 500'	Depth to Static Water Level 40'
TYPE OF COMPLETION: (Circle One or More): Gravel Packed, Underreamed, Telescoped, <input checked="" type="checkbox"/> Natural Development, Open Hole, Other _____ (Describe)		
Top of Lap Pipe or Reduction in Casing		
FEET	IF TELESCOPED OR MORE THAN ONE SCREEN: USE BACK PAGE	

LOG DATA	
TYPE OF LOG RUN (Circle One): Electric, Gamma Ray, Density, Sonic, <input checked="" type="radio"/> Neutron, Other (Describe) _____	
Name of Organization Running Log	

SCREEN DATA		
Diameter - Inches 2"	Length - Feet 10'	Slot Size - Inches .0006
Screen Type PVC	Depth to Bottom - Feet 500'	

GEOLOGIC DATA (Office Use Only)			
Surface Elev.	Geologic Unit	Unit Thickness	Depth to Top
Subs. SWL	Date	Analysis	Aquifer Test

Driller's Remarks

RECEIVED


JUN 17 1988

Department of Natural Resources
Bureau of Land & Water Resources

DESCRIPTION OF FORMATIONS ENCOUNTERED	FROM	TO	FORMATION (Continued)	FROM	TO
mud	0	160			
sand	160	180			
mud	180	270			
sand	270	290			
mud	290	440			
sand	440	500			
IF MORE SPACE IS NEEDED, USE BACK					

If well telescopes please sketch and show depths.

GROUND LEVEL

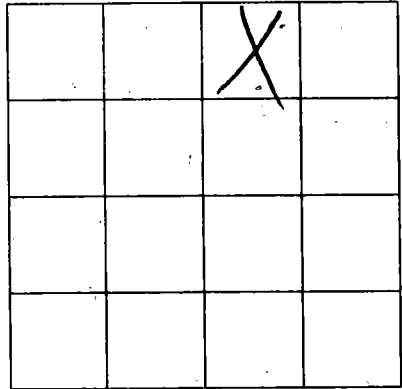

SECTION _____

Please indicate well location X.

ADDITIONAL INFORMATION

If more than one screen,
show location of each on sketch.