

**MISSISSIPPI DEPARTMENT OF NATURAL RESOURCES**

Bureau of Land and Water Resources

P.O. Box 10631

Jackson, Mississippi 39209

**WATER WELL DRILLERS LOG**

COUNTY WELL LOCATED <b>Jackson</b>	
WELL NUMBER <b>J2268</b>	CODED
DATE WELL COMPLETED <b>6-22-88</b>	

PERMIT NUMBER
NAME OF DRILLING FIRM <b>Coast Water Well Sew.</b>

NAME & MAILING ADDRESS OF LANDOWNER <b>Jim King</b>			
<b>10450 ANTIOCH RD</b>			
<b>VAN CLEAVE MS</b>			
WELL LOCATION: SEC	TOWNSHIP	RANGE	
<b>26</b>	<b>6</b>	<b>8</b>	<b>W</b>
DISTANCE	DIRECTION	NEAREST TOWN	
<b>5</b> Miles	<b>SW</b>	of <b>VAN CLEAVE</b>	
OTHER LANDMARK			
WELL PURPOSE: Home, Irrigation, Municipal, Industrial, Fish Pond, etc. <b>Home</b>			

<b>PUMP DATA</b>		
PUMP TYPE (Circle One): Submersible, Turbine, <b>Jet</b> , Flowing Well, Other (Describe)		
POWER TYPE (Circle One): <b>Electric</b> , Tractor, Diesel, Gasoline, Butane, Other (Describe)		
Pump Capacity (GPM) <b>12</b>	No. of Stages <b>2</b>	Setting Depth <b>-</b> FT.
PUMP TEST		
Well yielded <b>-</b> GPM with a drawdown of <b>-</b> ft. after <b>-</b> hours of pumping		

<b>WELL DATA</b>		
Well Depth <b>215' 20"</b>	Casing Diameter (In.) <b>2"</b>	Casing Length (Ft.) <b>200'</b>
Type of Casing <b>PVC</b>	Hole Depth <b>215'</b>	Depth to Static Water Level <b>20'</b>
TYPE OF COMPLETION: (Circle One or More): <b>Gravel Packed</b> , Underreamed, Telescoped, Natural Development, Open Hole, Other (Describe)		
Top of Lap Pipe or Reduction in Casing <b>FEET</b> IF TELESCOPED OR MORE THAN ONE SCREEN: USE BACK PAGE		

<b>LOG DATA</b>	
TYPE OF LOG RUN (Circle One): Electric, Gamma Ray, Density, Sonic, Neutron, Other (Describe) <b>No Log Run</b>	
Name of Organization Running Log	

<b>SCREEN DATA</b>		
Diameter - Inches <b>2"</b>	Length - Feet <b>10'</b>	Slot Size - Inches <b>.008</b>
Screen Type <b>PVC</b>	Depth to Bottom - Feet <b>210'</b>	

<b>GEOLOGIC DATA (Office Use Only)</b>			
Surface Elev.	Geologic Unit	Unit Thickness	Depth to Top
Subs. SWL	Date	Analysis	Aquifer Test


Driller's Remarks
<b>RECEIVED</b>

DESCRIPTION OF FORMATIONS ENCOUNTERED	FROM	TO
<b>Top Soil</b>	<b>0</b>	<b>2</b>
<b>Brown Clay</b>	<b>2</b>	<b>20</b>
<b>Red Coarse Sand</b>	<b>20</b>	<b>106</b>
<b>Blue Clay</b>	<b>106</b>	<b>185</b>
<b>Gray Coarse Sand</b>	<b>185</b>	<b>210</b>
<b>Blue Clay</b>	<b>210</b>	<b>215</b>

FORMATIONS (Continued)	FROM	TO
<b>NOV 15 1988</b>		
<b>Department of Natural Resources Bureau of Land &amp; Water Resources</b>		
IF MORE SPACE IS NEEDED, USE BACK		

If well telescopes please sketch and show depths.

GROUND LEVEL

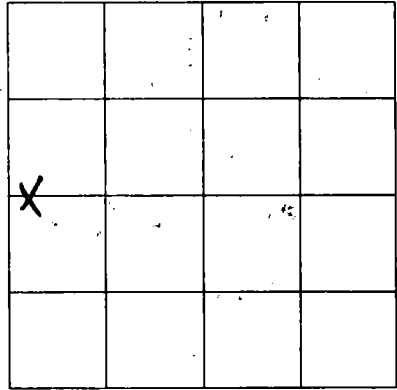

SECTION 26

Please indicate well location X.

ADDITIONAL INFORMATION

If more than one screen, show location of each on sketch.