

MISSISSIPPI DEPARTMENT OF NATURAL RESOURCES
Bureau of Land and Water Resources

P.O. Box 10631
Jackson, Mississippi 39209
WATER WELL DRILLERS LOG

COUNTY WELL LOCATED JACKSON	
WELL NUMBER J 2270	CODED
DATE WELL COMPLETED 15 July 89	

PERMIT NUMBER 0-485
NAME OF DRILLING FIRM CORETEC
WRIGHT - STOUT

NAME & MAILING ADDRESS OF LANDOWNER Mr. ALLEN PREVOST			
RIGHTWOOD ROAD			
OCEAN SPRINGS, Ms 39564			
WELL LOCATION:	SEC	TOWNSHIP	RANGE
	23	6 N	8 E
DISTANCE	DIRECTION	NEAREST TOWN	
5 Miles	WEST	VANCELAKE	
OTHER LANDMARK NEAR HUMANEY FARMS			
WELL PURPOSE: Home, Irrigation, Municipal, Industrial, Fish Pond, etc. HOME			


PUMP DATA		
PUMP TYPE (Circle One): Submersible, Turbine, Jet Flowing Well, Other (Describe) _____		
POWER TYPE (Circle One): Electric , Tractor, Diesel, Gasoline, Butane, Other (Describe) _____		
Pump Capacity (GPM) 20	No. of Stages 2	Setting Depth 84' FT.
PUMP TEST		
Well yielded 12 GPM with a drawdown of 10 ft. after 2 hours of pumping		

WELL DATA		
Well Depth 203	Casing Diameter (In.) 2"	Casing Length (Ft.) 193'
Type of Casing PVC	Hole Depth 204	Depth to Static Water Level 62'
TYPE OF COMPLETION: (Circle One or More): Natural Development , Underreamed, Telescoped, Gravel Packed, Open Hole, Other (Describe) _____		
Top of Lap Pipe or Reduction in Casing N/A FEET		
IF TELESCOPED OR MORE THAN ONE SCREEN: USE BACK PAGE		

LOG DATA	
TYPE OF LOG RUN (Circle One): Electric, Gamma Ray, Density, Sonic, No Log Run , Neutron, Other (Describe) _____	
Name of Organization Running Log	

SCREEN DATA		
Diameter - Inches 2"	Length - Feet 10'	Slot Size - Inches #10
Screen Type PVC	Depth to Bottom - Feet 193' (203')	


GEOLOGIC DATA (Office Use Only)			
Surface Elev.	Geologic Unit	Unit Thickness	Depth to Top
Subs. SWL	Date	Analysis	Aquifer Test
Driller's Remarks			

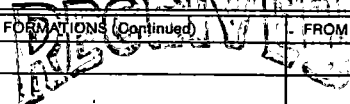DESCRIPTION OF FORMATIONS ENCOUNTERED	FROM	TO	FORMATIONS (Continued)	FROM	TO
TOP SOIL	0	2	 OCT 21 1989 Department of Natural Resources Bureau of Land & Water Resources		
WHITE SAND - COURSE	2	8			
RED Clay	8	14			
COURSE RED SAND	14	18			
GREY POTTER'S CLAY	18	20			
COURSE WHITE SAND	20	63			
GREY CLAY	63	77			
FINE GREY SAND + MUD	77	144			
MED - COURSE S/P SAND	144	166			
COURSE S/P SAND	166	188			
COURSE S/P SAND + PEA GRAVEL	188	203			

IF MORE SPACE IS NEEDED, USE BACK

If well telescopes please sketch and show depths.

GROUND LEVEL

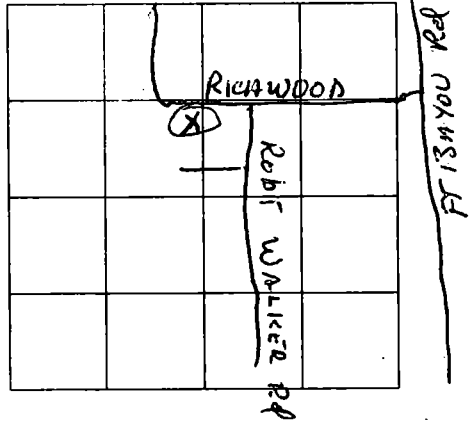

SECTION 23

Please indicate well location X.

ADDITIONAL INFORMATION

If more than one screen, show location of each on sketch.