

MISSISSIPPI DEPARTMENT OF NATURAL RESOURCES

Bureau of Land and Water Resources

P.O. Box 10631

Jackson, Mississippi 39209

WATER WELL DRILLERS LOG

COUNTY WELL LOCATED <i>Jackson</i>	
WELL NUMBER <i>J 2992</i>	CODED
DATE WELL COMPLETED <i>5-22-90</i>	

PERMIT NUMBER
NAME OF DRILLING FIRM <i>Coast Water Well Dr. Inc.</i>

NAME & MAILING ADDRESS OF LANDOWNER <i>Ethel Hughes</i>		
<i>McClelland Rd.</i>		
<i>Ocean Springs, Ms.</i>		
WELL LOCATION: SEC	TOWNSHIP	RANGE
<i>35</i>	<i>6^N</i>	<i>9^W</i>
DISTANCE	DIRECTION	NEAREST TOWN
<i>5</i> Miles	<i>NW</i>	<i>Ocean Springs</i>
OTHER LANDMARK		
WELL PURPOSE: <input checked="" type="checkbox"/> Home, <input type="checkbox"/> Irrigation, <input type="checkbox"/> Municipal, <input type="checkbox"/> Industrial, <input type="checkbox"/> Fish Pond, etc.		

PUMP DATA		
PUMP TYPE (Circle One): Submersible, Turbine, <input checked="" type="radio"/> Jet, Flowing Well, Other (Describe) _____		
POWER TYPE (Circle One): <input checked="" type="radio"/> Electric, Tractor, Diesel, Gasoline, Butane, Other (Describe) _____ H/P <i>2</i>		
Pump Capacity (GPM) <i>10</i>	No. of Stages <i>3</i>	Setting Depth _____ FT.
PUMP TEST		
Well yielded _____ GPM with a drawdown of _____ ft. after _____ hours of pumping		

WELL DATA		
Well Depth <i>425'</i>	Casing Diameter (In.) <i>2"</i>	Casing Length (Ft.) <i>400'</i>
Type of Casing <i>PVC</i>	Hole Depth <i>425'</i>	Depth to Static Water Level <i>89'</i>
TYPE OF COMPLETION: (Circle One or More): <input checked="" type="checkbox"/> Gravel Packed, <input type="checkbox"/> Underreamed, <input type="checkbox"/> Telescoped, <input checked="" type="checkbox"/> Natural Development, <input type="checkbox"/> Open Hole, <input type="checkbox"/> Other		
Top of Lap Pipe or Reduction in Casing _____ FEET <input type="checkbox"/> IF TELESCOPED OR MORE THAN ONE SCREEN: USE BACK PAGE		

LOG DATA	
TYPE OF LOG RUN (Circle One): Electric, Gamma Ray, Density, Sonic, <input checked="" type="radio"/> No Log Run, Neutron, Other (Describe) _____	
Name of Organization Running Log	

SCREEN DATA		
Diameter - Inches <i>2"</i>	Length - Feet <i>10'</i>	Slot Size - Inches
Screen Type <i>PVC</i>	Depth to Bottom - Feet <i>400'</i>	

GEOLOGIC DATA (Office Use Only)			
Surface Elev.	Geologic Unit	Unit Thickness	Depth to Top
Subs. SWL	Date	Analysis	Aquifer Test
Driller's Remarks			

DESCRIPTION OF FORMATIONS ENCOUNTERED	FROM	TO	FORMATIONS (Continued)	FROM	TO
<i>Top soil</i>	<i>0</i>	<i>4</i>			
<i>Yellow/gray clay</i>	<i>4</i>	<i>15</i>			
<i>Black mud</i>	<i>15</i>	<i>25</i>			
<i>Coarse sand & shells</i>	<i>25</i>	<i>40</i>			
<i>Blue clay / streaky sand</i>	<i>40</i>	<i>230</i>			
<i>Fine sand</i>	<i>230</i>	<i>240</i>			
<i>Blue clay / streaky sand</i>	<i>240</i>	<i>350</i>			
<i>Fine to coarse sand</i>	<i>350</i>	<i>425</i>			

RECEIVED


OCT 12 1990

Department of Natural Resources
Bureau of Land & Water Resources

IF MORE SPACE IS NEEDED, USE BACK

If well telescopes please sketch and show depths.

GROUND LEVEL

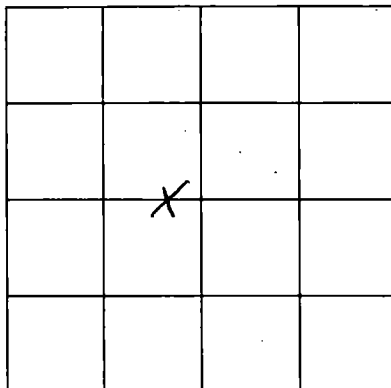

SECTION 35

Please indicate well location X.

ADDITIONAL INFORMATION

If more than one screen, show location of each on sketch.