

MISSISSIPPI DEPARTMENT OF NATURAL RESOURCES

Bureau of Land and Water Resources

Southport Mall

P.O. Box 10631

Jackson, Mississippi 39209

WATER WELL DRILLERS LOG

JACKSON
J 2293

8/16 1989
date well completed

1989

Springer Son
firm name

Jackson
county well located

LANDOWNER:

JA Construction

(Joe Mularzo)

(mailing address)

WELL LOCATION:

sec. T 6 N R 7 E
S W

(distance) miles (direction) of (nearest town)

WELL PURPOSE:

Home
(home) irrigation, municipal, industrial

WELL COMPLETION DATA:

- (1) diameter (inches) 2"
- (2) total depth (feet) 190'
- (3) static water level (feet) 35' below top of ground.

- (4) casing PVC 180'
(material) (depth)

(size) if telescope see back.

- (5) screen 10' 180'
(length) (depth to top)

2" PVC
(size) (material)

- (6) pump 1 13
(HP) (yield gpm)

SREPA
(type power)

- (7) electric log No
(yes or no)

(organization running log)

- (8) how well bottom plugged PVC.
Back wash valve

DRILLERS REMARKS:

description of formations encountered

from

to


180
10
190

RECEIVED
JUL 23 1989

Department of Natural Resources
Bureau of Land & Water Resources

If well telescopes please sketch and show depths.

GROUND LEVEL

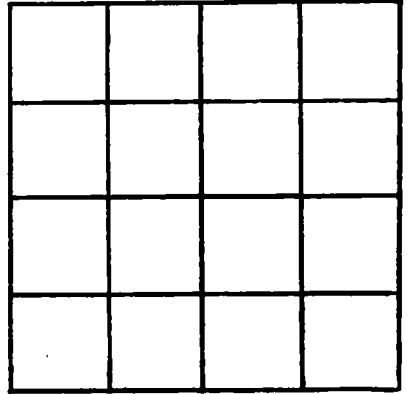

SECTION _____

Please indicate well location X.

ADDITIONAL INFORMATION

If more than one screen, show locations of each on sketch.