

# MISSISSIPPI DEPARTMENT OF NATURAL RESOURCES

Bureau of Land and Water Resources

P.O. Box 10631

Jackson, Mississippi 39209

**WATER WELL DRILLERS LOG**

COUNTY WELL LOCATED <u>Jackson</u>	
WELL NUMBER <u>17296</u>	CODED
<del>██████████</del>	
DATE WELL COMPLETED <u>July 18-90</u>	

PERMIT NUMBER <u>0239</u>
NAME OF DRILLING FIRM <u>Yms Hill Pump &amp; Wells</u>

NAME & MAILING ADDRESS OF LANDOWNER <u>David Parker</u>			
WELL LOCATION:	SEC <u>29</u>	TOWNSHIP <u>6 N</u>	RANGE <u>8 E</u>
DISTANCE	DIRECTION	NEAREST TOWN	
<u>12</u> Miles	<u>North</u>	<u>Ocean Springs</u>	
OTHER LANDMARK <u>Off Hwy 57</u>			
WELL PURPOSE: <input checked="" type="checkbox"/> Home, <input type="checkbox"/> Irrigation, <input type="checkbox"/> Municipal, <input type="checkbox"/> Industrial, <input type="checkbox"/> Fish Pond, etc.			

<b>PUMP DATA</b>		
PUMP TYPE (Circle One): Submersible, Turbine, <u>Jet</u> Flowing Well, Other (Describe) _____		
POWER TYPE (Circle One): <u>Electric</u> , Tractor, Diesel, Gasoline, Butane, Other (Describe) _____ H/P _____		
Pump Capacity (GPM) <u>10</u>	No. of Stages <u>2</u>	Setting Depth <u>100'</u> FT.
PUMP TEST Well yielded <u>10</u> GPM with a drawdown of <u>10</u> ft. after <u>1</u> hours of pumping		

<b>WELL DATA</b>		
Well Depth <u>300</u>	Casing Diameter (In.) <u>2"</u>	Casing Length (Ft.) <u>20'</u>
Type of Casing <u>Pvc</u>	Hole Depth <u>300'</u>	Depth to Static Water Level <u>70'</u>
TYPE OF COMPLETION: (Circle One or More): <u>Natural Development</u> , Gravel Packed, Underreamed, Telescoped, Open Hole, Other		
Top of Lap Pipe or Reduction in Casing  FEET <input type="checkbox"/> IF TELESCOPED OR MORE THAN ONE SCREEN: USE BACK PAGE		

<b>LOG DATA</b>	
TYPE OF LOG RUN (Circle One): Electric, Gamma Ray, Density, Sonic, <u>No Log Run</u> , Neutron, Other (Describe) _____	
Name of Organization Running Log _____	

<b>SCREEN DATA</b>		
Diameter - Inches <u>2"</u>	Length - Feet <u>10'</u>	Slot Size - Inches <u>.0006</u>
Screen Type <u>Pvc</u>	Depth to Bottom - Feet <u>300'</u>	

<b>GEOLOGIC DATA (Office Use Only)</b>			
Surface Elev.	Geologic Unit	Unit Thickness	Depth to Top
Subs. SWL	Date	Analysis	Aquifer Test
Driller's Remarks			

DESCRIPTION OF FORMATIONS ENCOUNTERED	FROM	TO	FORMATIONS (Continued)	
			FROM	TO
<u>mud</u>	<u>0</u>	<u>210</u>		
<u>sand</u>	<u>210</u>	<u>220</u>		
<u>mud</u>	<u>220</u>	<u>270</u>		
<u>sand</u>	<u>270</u>	<u>300</u>		

RECEIVED


AUG 16 1990

Department of Natural Resources  
Bureau of Land & Water Resources

IF MORE SPACE IS NEEDED, USE BACK

If well telescopes please  
sketch and show depths.

GROUND LEVEL

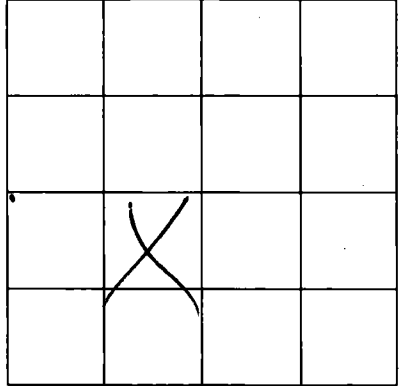

SECTION \_\_\_\_\_

Please indicate well location X.

ADDITIONAL INFORMATION

If more than one screen,  
show location of each on sketch.