


If well telescopes please sketch and show depths.

GROUND LEVEL

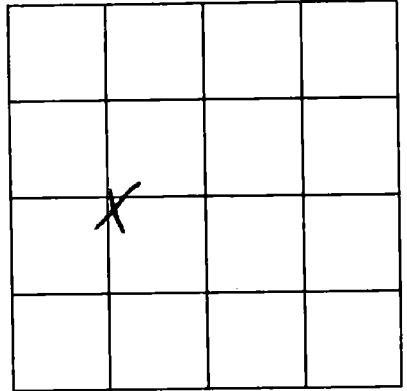

10

SECTION _____

Please indicate well location X.

ADDITIONAL INFORMATION

Lined area for additional information.

If more than one screen, show location of each on sketch.