


If well telescopes please sketch and show depths.

GROUND LEVEL

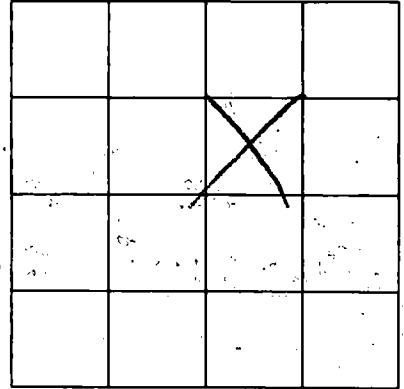

SECTION _____

Please indicate well location X.

ADDITIONAL INFORMATION

A series of horizontal lines for writing additional information.



Faint handwritten notes or scribbles.

If more than one screen, show location of each on sketch.