

MISSISSIPPI DEPARTMENT OF ENVIRONMENTAL QUALITY
Bureau of Land and Water Resources

P. O. Box 10631
Jackson, MS 39289-0631
WATER WELL DRILLERS LOG

COUNTY WELL LOCATED <i>Jackson</i>	
WELL NUMBER <i>79395</i>	CODED
DATE WELL COMPLETED <i>2-9-92</i>	

PERMIT NUMBER
NAME OF DRILLING FIRM <i>Coast Water Well Ser. Inc.</i>

NAME & MAILING ADDRESS OF LANDOWNER <i>Pat & Sussett Sterling Janner</i>			
WELL LOCATION: SEC <u>12</u> TOWNSHIP <u>6^N 8^E</u> RANGE <u>8^W</u>			
DISTANCE <u>3</u> Miles	DIRECTION <u>west</u>	NEAREST TOWN <u>Thadborne</u>	
OTHER LANDMARK			
WELL PURPOSE: <input checked="" type="checkbox"/> Home, <input type="checkbox"/> Irrigation, <input type="checkbox"/> Municipal, <input type="checkbox"/> Industrial, <input type="checkbox"/> Fish Pond, etc.			

PUMP DATA		
PUMP TYPE (Circle One): Submersible, Turbine, <input checked="" type="radio"/> Jet, Flowing Well, Other (Describe) _____		
POWER TYPE (Circle One): <input checked="" type="radio"/> Electric, Tractor, Diesel, Gasoline, Butane, Other (Describe) _____ H/P <u>1/2 hp</u>		
Pump Capacity (GPM)	No. of Stages	Setting Depth FT.
PUMP TEST		
Well yielded _____ GPM with a drawdown of _____ ft. after _____ hours of pumping		

WELL DATA		
Well Depth <u>80'</u>	Casing Diameter (In.) <u>2"</u>	Casing Length (Ft.) <u>70'</u>
Type of Casing <u>PVC</u>	Hole Depth <u>80'</u>	Depth to Static Water Level <u>25'</u>
TYPE OF COMPLETION: (Circle One or More): <input type="checkbox"/> Gravel Packed, <input type="checkbox"/> Underreamed, <input type="checkbox"/> Telescoped, <input type="checkbox"/> Natural Development, <input type="checkbox"/> Open Hole, <input type="checkbox"/> Other (Describe) _____		
Top of Lap Pipe or Reduction in Casing FEET <input type="checkbox"/> IF TELESCOPED OR MORE THAN ONE SCREEN: USE BACK PAGE		

LOG DATA	
TYPE OF LOG RUN (Circle One): Electric, Gamma Ray, Density, Sonic, Neutron, Other (Describe) _____ <input checked="" type="radio"/> No Log Run	
Name of Organization Running Log	

SCREEN DATA		
Diameter - Inches <u>2"</u>	Length - Feet <u>10'</u>	Slot Size - Inches <u>.008</u>
Screen Type <u>PVC</u>	Depth to Bottom - Feet <u>80'</u>	

GEOLOGIC DATA (Office Use Only)			
Surface Elev.	Geologic Unit	Unit Thickness	Depth to Top
Subs. SWL	Date	Analysis	Aquifer Test


Driller's Remarks

DESCRIPTION OF FORMATIONS ENCOUNTERED	FROM	TO
<i>top soil</i>	<i>0</i>	<i>2</i>
<i>red clay</i>	<i>2</i>	<i>12</i>
<i>coarse red sand</i>	<i>12</i>	<i>25</i>
<i>coarse white sand</i>	<i>25</i>	<i>80</i>

FORMATIONS (Continued)	FROM	TO
RECEIVED		
MAR 23 1992		
Dept. of Environmental Quality Bureau of Land & Water Resources		
IF MORE SPACE IS NEEDED, USE BACK		

If well telescopes please sketch and show depths.

GROUND LEVEL

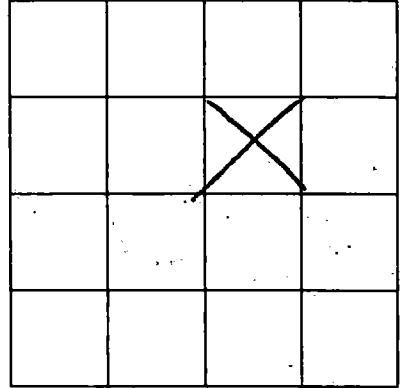

SECTION _____

Please indicate well location X.

ADDITIONAL INFORMATION

Multiple horizontal lines for writing additional information.

DEVIATION

111

THIS WELL IS TO BE USED FOR WATER SUPPLY

If more than one screen, show location of each on sketch.