

MISSISSIPPI DEPARTMENT OF ENVIRONMENTAL QUALITY
Bureau of Land and Water Resources

P. O. Box 10631
Jackson, MS 39289-0631
WATER WELL DRILLERS LOG

COUNTY WELL LOCATED <i>Jackson</i>	
WELL NUMBER <i>J 2336</i>	CODED
DATE WELL COMPLETED <i>8-3-92</i>	

PERMIT NUMBER
NAME OF DRILLING FIRM <i>Coast Water Well Service</i>

NAME & MAILING ADDRESS OF LANDOWNER <i>Mike Chisolm</i>			
WELL LOCATION: SEC <u>13</u> TOWNSHIP <u>6 N</u> RANGE <u>8 E</u>			
DISTANCE	DIRECTION	NEAREST TOWN	
<u>3</u> Miles	<u>W</u>	of <u>Hardeeville</u>	
OTHER LANDMARK			
WELL PURPOSE: <input checked="" type="checkbox"/> Home Irrigation, Municipal, Industrial, Fish Pond, etc.			

PUMP DATA		
PUMP TYPE (Circle One): Submersible, Turbine, <u>Jet</u> Flowing Well, Other (Describe) _____		
POWER TYPE (Circle One): <u>Electric</u> Tractor, Diesel, Gasoline, Butane, Other (Describe) _____ H/P <u>1</u>		
Pump Capacity (GPM) <u>5</u>	No. of Stages <u>2</u>	Setting Depth <u> </u> FT.
PUMP TEST		
Well yielded _____ GPM with a drawdown of _____ ft. after _____ hours of pumping		


WELL DATA		
Well Depth <u>430'</u>	Casing Diameter (In.) <u>2"</u>	Casing Length (Ft.) <u>413'</u>
Type of Casing <u>PVC</u>	Hole Depth <u>430'</u>	Depth to Static Water Level <u>90'</u>
TYPE OF COMPLETION: (Circle One or More): <input checked="" type="checkbox"/> Gravel Packed, <input type="checkbox"/> Underreamed, <input type="checkbox"/> Telescoped, <input checked="" type="checkbox"/> Natural Development, <input type="checkbox"/> Open Hole, <input type="checkbox"/> Other (Describe) _____		
Top of Lap Pipe or Reduction in Casing <u> </u> FEET		
IF TELESCOPED OR MORE THAN ONE SCREEN: USE BACK PAGE		

LOG DATA	
TYPE OF LOG RUN (Circle One): Electric, Gamma Ray, Density, <u>No Log Run</u> , Other (Describe) <u>Sonic, Neutron</u>	
Name of Organization Running Log <u> </u>	

SCREEN DATA		
Diameter - Inches <u>2"</u>	Length - Feet <u>10'</u>	Slot Size - Inches <u>.008</u>
Screen Type <u>PVC</u>	Depth to Bottom - Feet <u>423</u>	

GEOLOGIC DATA (Office Use Only)			
Surface Elev.	Geologic Unit	Unit Thickness	Depth to Top
Subs. SWL	Date	Analysis	Aquifer Test
Driller's Remarks <u> </u>			

DESCRIPTION OF FORMATIONS ENCOUNTERED	FROM	TO
<i>Top soil</i>	<i>0</i>	<i>2</i>
<i>Yellow/Blue clay</i>	<i>2</i>	<i>70</i>
<i>Coarse sand/gravel</i>	<i>70</i>	<i>175</i>
<i>Blue clay/sand</i>	<i>175</i>	<i>385</i>
<i>Med. sand</i>	<i>385</i>	<i>425</i>
<i>Blue clay</i>	<i>425</i>	<i>430</i>

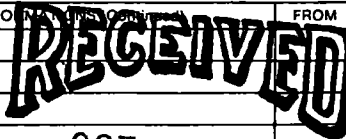


OCT 07 1992

Dept. of Environmental Quality
Bureau of Land & Water Resources

IF MORE SPACE IS NEEDED, USE BACK

If well telescopes please sketch and show depths.

GROUND LEVEL

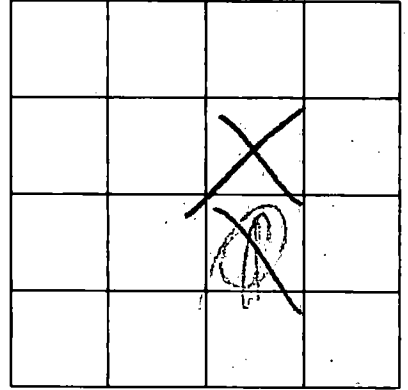

SECTION _____

Please indicate well location X:

ADDITIONAL INFORMATION

DELIVERED

PROCESSED BY THE
FEDERAL BUREAU OF INVESTIGATION

If more than one screen,
show location of each on sketch.