

MISSISSIPPI DEPARTMENT OF ENVIRONMENTAL QUALITY
Bureau of Land and Water Resources

P. O. Box 10631
Jackson, MS 39289-0631
WATER WELL DRILLERS LOG

COUNTY WELL LOCATED <i>Jackson</i>
WELL NUMBER CODED <i>59338</i>
DATE WELL COMPLETED <i>6-24-92</i>

PERMIT NUMBER
NAME OF DRILLING FIRM <i>Coast Water Well Serv. Inc.</i>

NAME & MAILING ADDRESS OF LANDOWNER <i>Raymond Page</i>
WELL LOCATION: SEC <i>25</i> TOWNSHIP <i>6 N</i> RANGE <i>8 W</i>
DISTANCE <i>3 1/2</i> Miles DIRECTION <i>SW</i> of NEAREST TOWN <i>Thuleave</i>
OTHER LANDMARK
WELL PURPOSE <input checked="" type="checkbox"/> Home Irrigation, Municipal, Industrial, Fish Pond, etc.

PUMP DATA		
PUMP TYPE (Circle One): Submersible, Turbine, <input checked="" type="radio"/> Jet, Flowing Well, Other (Describe) _____		
POWER TYPE (Circle One): <input checked="" type="radio"/> Electric, Tractor, Diesel, Gasoline, Butane, Other (Describe) _____ H/P <i>1</i>		
Pump Capacity (GPM) <i>6</i>	No. of Stages <i>2</i>	Setting Depth FT.
PUMP TEST Well yielded _____ GPM with a drawdown of _____ ft. after _____ hours of pumping		


WELL DATA		
Well Depth <i>362'</i>	Casing Diameter (In.) <i>2"</i>	Casing Length (Ft.) <i>352'</i>
Type of Casing <i>PVC</i>	Hole Depth <i>368'</i>	Depth to Static Water Level <i>67'</i>
TYPE OF COMPLETION: (Circle One or More): <input checked="" type="checkbox"/> Gravel Packed, <input type="checkbox"/> Underreamed, <input type="checkbox"/> Telescoped, <input checked="" type="checkbox"/> Natural Development, <input type="checkbox"/> Open Hole, <input type="checkbox"/> Other (Describe) _____		
Top of Lap Pipe or Reduction in Casing FEET IF TELESCOPED OR MORE THAN ONE SCREEN: USE BACK PAGE		

LOG DATA	
TYPE OF LOG RUN (Circle One): Electric, Gamma Ray, Density, Sonic, Neutron, Other (Describe) _____	
Name of Organization Running Log <i>No Log Run</i>	

SCREEN DATA		
Diameter - Inches <i>2"</i>	Length - Feet <i>10'</i>	Slot Size - Inches <i>.008</i>
Screen Type <i>PVC</i>	Depth to Bottom - Feet <i>362'</i>	

GEOLOGIC DATA (Office Use Only)			
Surface Elev.	Geologic Unit	Unit Thickness	Depth to Top
Subs. SWL	Date	Analysis	Aquifer Test
Driller's Remarks			

DESCRIPTION OF FORMATIONS ENCOUNTERED	FROM	TO
<i>Top soil</i>	<i>0</i>	<i>2</i>
<i>yellow clay</i>	<i>2</i>	<i>19</i>
<i>fine sand</i>	<i>18</i>	<i>50</i>
<i>Blue Clay</i>	<i>50</i>	<i>80</i>
<i>med. sand</i>	<i>80</i>	<i>105</i>
<i>Blue Clay 3 of sand</i>	<i>105</i>	<i>170</i>
<i>med. sand</i>	<i>170</i>	<i>190</i>
<i>Blue Clay 3 of sand</i>	<i>190</i>	<i>280</i>
<i>fine sand 3 of clay</i>	<i>280</i>	<i>320</i>
<i>coarse sand</i>	<i>320</i>	<i>364</i>
<i>Blue Clay</i>	<i>364</i>	<i>368</i>

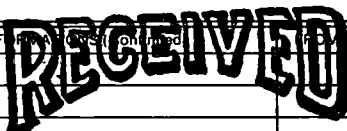


OCT 07 1992

Dept. of Environmental Quality
Bureau of Land & Water Resources

IF MORE SPACE IS NEEDED, USE BACK

If well telescopes please sketch and show depths.

GROUND LEVEL

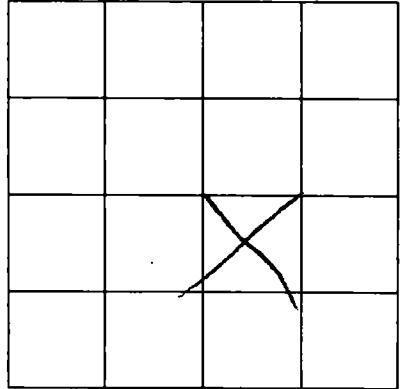

SECTION _____

Please indicate well location X.

ADDITIONAL INFORMATION

RECEIVED

SEP 11 1960

U.S. GEOLOGICAL SURVEY
WATER RESOURCES DIVISION
WASHINGTON, D.C. 20540

If more than one screen,
show location of each on sketch.