


If well telescopes please sketch and show depths.

GROUND LEVEL

01

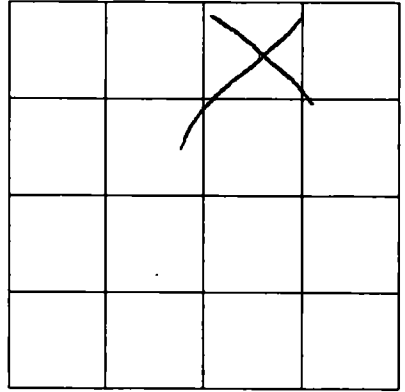

SECTION _____

Please indicate well location X.

ADDITIONAL INFORMATION

DELETED

Handwritten notes or stamps, possibly including "1961" and "1962".

If more than one screen, show location of each on sketch.