

**MISSISSIPPI DEPARTMENT OF ENVIRONMENTAL QUALITY**  
Bureau of Land and Water Resources

P. O. Box 10631  
Jackson, MS 39289-0631  
**WATER WELL DRILLERS LOG**

COUNTY WELL LOCATED <i>Jackson</i>	
WELL NUMBER <i>57347</i>	CODED
DATE WELL COMPLETED <i>6-16-92</i>	

PERMIT NUMBER
NAME OF DRILLING FIRM <i>Coast Water Well, Inc.</i>

NAME & MAILING ADDRESS OF LANDOWNER <i>Robert Crew</i>			
WELL LOCATION: SEC <i>14</i> TOWNSHIP <i>6 N</i> RANGE <i>8 E</i>			
DISTANCE <i>4</i> Miles	DIRECTION <i>W/SW</i>	NEAREST TOWN <i>Madison</i>	
OTHER LANDMARK			
WELL PURPOSE: <u>Home</u> Irrigation, Municipal, Industrial, Fish Pond, etc.			

<b>PUMP DATA</b>		
PUMP TYPE (Circle One): Submersible, Turbine, <u>Jet</u> Flowing Well, Other (Describe)		
POWER TYPE (Circle One): <u>Electric</u> , Tractor, Diesel, Gasoline, Butane, Other (Describe) <u>H/P 2</u>		
Pump Capacity (GPM) <i>9</i>	No. of Stages <i>3</i>	Setting Depth <i>        </i> FT.
PUMP TEST		
Well yielded <i>        </i> GPM with a drawdown of <i>        </i> ft. after <i>        </i> hours of pumping		

<b>WELL DATA</b>		
Well Depth <i>516'</i>	Casing Diameter (In.) <i>2"</i>	Casing Length (Ft.) <i>502'</i>
Type of Casing <i>PVC</i>	Hole Depth <i>516'</i>	Depth to Static Water Level <i>66'</i>
TYPE OF COMPLETION: (Circle One or More): <u>Natural Development</u> , Gravel Packed, Underreamed, Telescoped, Open Hole, Other		
Top of Lap Pipe or Reduction in Casing FEET IF TELESCOPED OR MORE THAN ONE SCREEN: USE BACK PAGE		

<b>LOG DATA</b>	
TYPE OF LOG RUN (Circle One): Electric, Gamma Ray, Density, Sonic, <u>No Log Run</u> , Other (Describe)	
Name of Organization Running Log	

<b>SCREEN DATA</b>		
Diameter - Inches <i>2"</i>	Length - Feet <i>10'</i>	Slot Size - Inches <i>.008</i>
Screen Type <i>PVC</i>	Depth to Bottom - Feet <i>516' 512'</i>	

<b>GEOLOGIC DATA (Office Use Only)</b>			
Surface Elev.	Geologic Unit	Unit Thickness	Depth to Top
Subs. SWL	Date	Analysis	Aquifer Test
Driller's Remarks			

DESCRIPTION OF FORMATIONS ENCOUNTERED	FROM	TO	FORM	TO
<i>Top soil</i>	<i>0</i>	<i>2</i>		
<i>clayey clay</i>	<i>2</i>	<i>20</i>		
<i>Coarse sand &amp; rubble</i>	<i>20</i>	<i>62</i>		
<i>gray clay s of sand</i>	<i>62</i>	<i>134</i>		
<i>Med sand</i>	<i>134</i>	<i>170</i>		
<i>blue clay s of sand</i>	<i>170</i>	<i>385</i>		
<i>fine sand s of clay</i>	<i>385</i>	<i>420</i>		
<i>brassy sand</i>	<i>420</i>	<i>512</i>		
<i>blue clay</i>	<i>512</i>	<i>516</i>		

**RECEIVED**


OCT 07 1992

Dept. of Environmental Quality  
Bureau of Land & Water Resources

IF MORE SPACE IS NEEDED, USE BACK

If well telescopes please sketch and show depths.

GROUND LEVEL

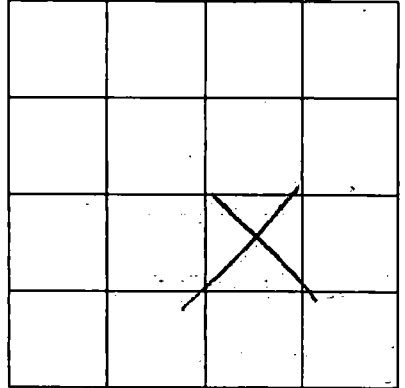

SECTION \_\_\_\_\_

Please indicate well location X.

ADDITIONAL INFORMATION

RECEIVED

NOV 19 1964

U.S. GEOLOGICAL SURVEY

If more than one screen, show location of each on sketch.