

**MISSISSIPPI DEPARTMENT OF ENVIRONMENTAL QUALITY**  
Bureau of Land and Water Resources

P. O. Box 10631  
Jackson, MS 39289-0631  
**WATER WELL DRILLERS LOG**

COUNTY WELL LOCATED <i>Jackson</i>	
WELL NUMBER <i>57348</i>	CODED
DATE WELL COMPLETED <i>9-25-92</i>	

PERMIT NUMBER
NAME OF DRILLING FIRM <i>Coast Waterwell, Inc</i>

NAME & MAILING ADDRESS OF LANDOWNER <i>Mark Endt</i>			
WELL LOCATION: SEC <i>12</i> TOWNSHIP <i>6</i> RANGE <i>N 8 E</i>			
DISTANCE <i>3</i> Miles	DIRECTION <i>W</i>	NEAREST TOWN <i>Threave</i>	
OTHER LANDMARK			
WELL PURPOSE: <input checked="" type="checkbox"/> Home, <input type="checkbox"/> Irrigation, <input type="checkbox"/> Municipal, <input type="checkbox"/> Industrial, <input type="checkbox"/> Fish Pond, etc.			

<b>PUMP DATA</b>		
PUMP TYPE (Circle One): Submersible, Turbine, <input checked="" type="radio"/> Jet, Flowing Well, Other (Describe) _____		
POWER TYPE (Circle One): <input checked="" type="radio"/> Electric, <input type="radio"/> Tractor, <input type="radio"/> Diesel, <input type="radio"/> Gasoline, <input type="radio"/> Butane, Other (Describe) _____		
Pump Capacity (GPM) <i>7</i>	No. of Stages	Setting Depth _____ FT.
PUMP TEST Well yielded _____ GPM with a drawdown of _____ ft. after _____ hours of pumping		

<b>WELL DATA</b>		
Well Depth <i>494'</i>	Casing Diameter (In.) <i>2"</i>	Casing Length (Ft.) <i>460'</i>
Type of Casing <i>PVC</i>	Hole Depth <i>494'</i>	Depth to Static Water Level <i>100'</i>
TYPE OF COMPLETION: (Circle One or More): <input checked="" type="checkbox"/> Gravel Packed, <input type="checkbox"/> Underreamed, <input type="checkbox"/> Telescoped, <input checked="" type="checkbox"/> Natural Development, <input type="checkbox"/> Open Hole, <input type="checkbox"/> Other (Describe) _____		
Top of Lap Pipe or Reduction in Casing _____ FEET IF TELESKOPED OR MORE THAN ONE SCREEN: USE BACK PAGE		

<b>LOG DATA</b>	
TYPE OF LOG RUN (Circle One): Electric, Gamma Ray, Density, <input checked="" type="radio"/> No Log Run, <input type="radio"/> Sonic, <input type="radio"/> Neutron, Other (Describe) _____	
Name of Organization Running Log	

<b>SCREEN DATA</b>		
Diameter - Inches <i>2"</i>	Length - Feet <i>10'</i>	Slot Size - Inches <i>.008</i>
Screen Type <i>PVC</i>	Depth to Bottom - Feet <i>470'</i>	

<b>GEOLOGIC DATA (Office Use Only)</b>			
Surface Elev.	Geologic Unit	Unit Thickness	Depth to Top
Subs. SWL	Date	Analysis	Aquifer Test
Driller's Remarks			

DESCRIPTION OF FORMATIONS ENCOUNTERED	FROM	TO	FORMATIONS (Continued)	FROM	TO
<i>Top soil</i>	<i>0</i>	<i>2</i>	<i>fine sand</i>	<i>474</i>	<i>494</i>
<i>Red clay</i>	<i>2</i>	<i>35</i>			
<i>Med. sand</i>	<i>35</i>	<i>58</i>			
<i>Gray clay</i>	<i>58</i>	<i>70</i>			
<i>Coarse sand</i>	<i>70</i>	<i>82</i>			
<i>Gray clay</i>	<i>82</i>	<i>98</i>			
<i>Coarse sand</i>	<i>98</i>	<i>130</i>			
<i>Blue clay s/s of sand</i>	<i>130</i>	<i>328</i>			
<i>fine sand</i>	<i>328</i>	<i>340</i>			
<i>Blue clay s/s of sand</i>	<i>340</i>	<i>440</i>			
<i>Coarse sand</i>	<i>440</i>	<i>474</i>			

**RECEIVED**


JAN 27 1993

Dept. of Environmental Quality

Bureau of Land and Water Resources

If well telescopes please  
sketch and show depths.

GROUND LEVEL

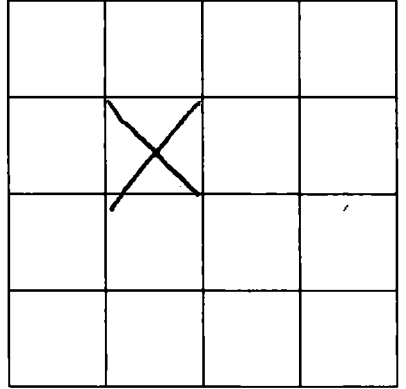

SECTION \_\_\_\_\_

Please indicate well location X.

ADDITIONAL INFORMATION

Lined area for additional information.

08 FEB 1973

6591 71 1 VBL

If more than one screen,  
show location of each on sketch.