

MISSISSIPPI DEPARTMENT OF ENVIRONMENTAL QUALITY

Office of Land and Water Resources

P. O. Box 10631
Jackson, MS 39289-0631
WATER WELL DRILLERS LOG

COUNTY WELL LOCATED <i>Jackson</i>
WELL NUMBER CODED <i>9-351</i>
DATE WELL COMPLETED <i>7-23-93</i>

PERMIT NUMBER
NAME OF DRILLING FIRM <i>Coast Water Well Service, Inc</i>

NAME & MAILING ADDRESS OF LANDOWNER <i>Galen Mallette</i>		
<i>Seaman Rd</i>		
<i>Vanceleave Ms</i>		
WELL LOCATION: SEC	TOWNSHIP	RANGE
<i>13</i>	<i>6</i>	<i>8</i>
DISTANCE DIRECTION NEAREST TOWN <i>3</i> Miles <i>West</i> of <i>Vanceleave</i>		
OTHER LANDMARK		
WELL PURPOSE <input checked="" type="checkbox"/> Home Irrigation, Municipal, Industrial, Fish Pond, etc.		

PUMP DATA		
PUMP TYPE (Circle One): <input checked="" type="checkbox"/> Submersible, Turbine, Jet, Flowing Well, Other (Describe) _____		
POWER TYPE (Circle One): <input checked="" type="checkbox"/> Electric, Tractor, Diesel, Gasoline, Butane, Other (Describe) _____ H/P <i>2</i>		
Pump Capacity (GPM) <i>35</i>	No. of Stages <i>12</i>	Setting Depth <i>130</i> FT.
PUMP TEST		
Well yielded _____ GPM with a drawdown of _____ ft. after _____ hours of pumping		

WELL DATA		
Well Depth <i>495'</i>	Casing Diameter (In.) <i>4" PVC 2" PVC</i>	Casing Length (Ft.) <i>210 ft. 4" 285 ft. 2"</i>
Type of Casing <i>PVC</i>	Hole Depth <i>495'</i>	Depth to Static Water Level <i>72'</i>
TYPE OF COMPLETION: (Circle One or More): <input checked="" type="checkbox"/> Gravel Packed, Underreamed, Telescoped, <input checked="" type="checkbox"/> Natural Development, <input type="checkbox"/> Open Hole, Other (Describe) _____		
WELL GROUTED TO A DEPTH OF <i>20</i> FEET Type Grout (circle one): <input checked="" type="checkbox"/> Cement, <input checked="" type="checkbox"/> Bentonite or Mix		

LOG DATA	
TYPE OF LOG RUN (Circle One): Electric, Gamma Ray, Density, Sonic, <input checked="" type="checkbox"/> No Log Run, Neutron, Other (Describe) _____	
Name of Organization Running Log	

SCREEN DATA		
Diameter - Inches <i>2"</i>	Length - Feet <i>20'</i>	Slot Size - Inches <i>.008</i>
Screen Type <i>PVC Sch. 80</i>		Depth to Bottom - Feet <i>495'</i>

GEOLOGIC DATA (Office Use Only)			
Surface Elev.	Geologic Unit	Unit Thickness	Depth to Top
Subs. SWL	Date	Analysis	Aquifer Test


Driller's Remarks

DESCRIPTION OF FORMATIONS ENCOUNTERED	FROM	TO	FORMATIONS (Continued)	FROM	TO
<i>Top soil</i>	<i>0</i>	<i>2</i>	RECEIVED AUG 18 1993 Dept. of Environmental Quality Office of Land & Water Resources		
<i>Red yellow clay</i>	<i>2</i>	<i>30</i>			
<i>fine to med sand</i>	<i>30</i>	<i>70</i>			
<i>Blue sand</i>	<i>70</i>	<i>120</i>			
<i>Coarse sand</i>	<i>120</i>	<i>150</i>			
<i>Blue clay</i>	<i>150</i>	<i>360</i>			
<i>fine sand</i>	<i>360</i>	<i>400</i>			
<i>Blue clay w/ streak sand</i>	<i>400</i>	<i>451</i>			
<i>Grey Coarse Sand</i>	<i>451</i>	<i>495</i>			

IF MORE SPACE IS NEEDED, USE BACK

If well telescopes please sketch and show depths.

GROUND LEVEL

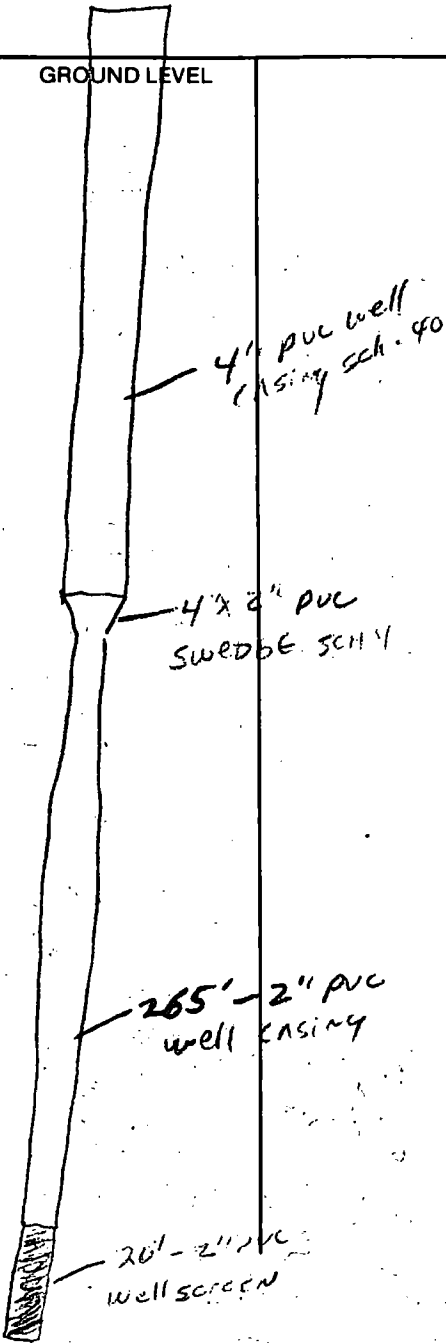

	X		

SECTION 13

Please indicate well location X.

ADDITIONAL INFORMATION

If more than one screen, show location of each on sketch.