

MISSISSIPPI DEPARTMENT OF ENVIRONMENTAL QUALITY

Office of Land and Water Resources

P. O. Box 10631
Jackson, MS 39289-0631
WATER WELL DRILLERS LOG

COUNTY WELL LOCATED <i>Jackson</i>	
WELL NUMBER <i>2364</i>	CODED
DATE WELL COMPLETED <i>4-29-93</i>	

PERMIT NUMBER
NAME OF DRILLING FIRM <i>Coast Water Well Ser. Inc.</i>

NAME & MAILING ADDRESS OF LANDOWNER <i>Craig Davis</i>		
<i>Southern Bay Lane</i>		
<i>Vanclave, Ms. 39564</i>		
WELL LOCATION: SEC	TOWNSHIP	RANGE
<i>24</i>	<i>6</i>	<i>8</i>
DISTANCE	DIRECTION	NEAREST TOWN
<i>4</i> Miles	<i>SE</i>	of <i>VANCLAVE</i>
OTHER LANDMARK		
WELL PURPOSE: <input checked="" type="radio"/> Home Irrigation, <input type="radio"/> Municipal, <input type="radio"/> Industrial, <input type="radio"/> Fish Pond, etc.		

PUMP DATA		
PUMP TYPE (Circle One): Submersible, Turbine, <input checked="" type="radio"/> Jet, <input type="radio"/> Flowing Well, Other (Describe) _____		
POWER TYPE (Circle One): <input checked="" type="radio"/> Electric, <input type="radio"/> Tractor, <input type="radio"/> Diesel, <input type="radio"/> Gasoline, <input type="radio"/> Butane, Other (Describe) _____ H/P <i>2</i>		
Pump Capacity (GPM) <i>10</i>	No. of Stages <i>3</i>	Setting Depth _____ FT.
PUMP TEST		
Well yielded _____ GPM with a drawdown of _____ ft. after _____ hours of pumping		

WELL DATA		
Well Depth <i>383</i>	Casing Diameter (In.) <i>2"</i>	Casing Length (Ft.) <i>373'</i>
Type of Casing <i>PVC</i>	Hole Depth <i>386'</i>	Depth to Static Water Level <i>95'</i>


LOG DATA	
TYPE OF LOG RUN (Circle One): Electric, Gamma Ray, Density, Sonic, Neutron, <input checked="" type="radio"/> No Log Run, Other (Describe) _____	
Name of Organization Running Log	

TYPE OF COMPLETION: (Circle One or More): <input checked="" type="radio"/> Gravel Packed, <input type="radio"/> Underreamed, <input type="radio"/> Telescoped, <input checked="" type="radio"/> Natural Development, <input type="radio"/> Open Hole, <input type="radio"/> Other (Describe) _____	
WELL GROUTED TO A DEPTH OF <i>20</i> FEET Type Grout (circle one): Cement, <input checked="" type="radio"/> Bentonite, or Mix	

GEOLOGIC DATA (Office Use Only)			
Surface Elev.	Geologic Unit	Unit Thickness	Depth to Top
Subs. SWL	Date	Analysis	Aquifer Test

SCREEN DATA		
Diameter - Inches <i>2"</i>	Length - Feet <i>10'</i>	Slot Size - Inches <i>.008"</i>
Screen Type <i>PVC</i>	Depth to Bottom - Feet <i>383'</i>	


Driller's Remarks

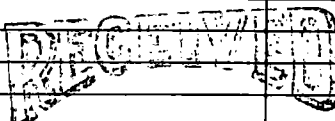DESCRIPTION OF FORMATIONS ENCOUNTERED	FROM	TO	FORMATIONS (Continued)	FROM	TO
<i>top soil</i>	<i>0</i>	<i>2'</i>	 JUL 19 1993 Dept. of Environmental Quality Office of Land & Water Resources		
<i>yellow/pink clay</i>	<i>2</i>	<i>40</i>			
<i>med. sand</i>	<i>40</i>	<i>80</i>			
<i>blue clay</i>	<i>80</i>	<i>180</i>			
<i>blue clay-silt sand</i>	<i>180</i>	<i>244</i>			
<i>med. sand</i>	<i>244</i>	<i>383</i>			
<i>blue clay</i>	<i>383</i>	<i>386</i>			

IF MORE SPACE IS NEEDED, USE BACK

If well telescopes please sketch and show depths.

GROUND LEVEL

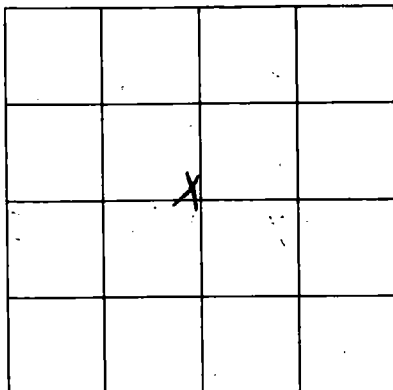

SECTION 24

Please indicate well location X.

ADDITIONAL INFORMATION

Lined area for additional information.

If more than one screen, show location of each on sketch.