

MISSISSIPPI DEPARTMENT OF ENVIRONMENTAL QUALITY

Office of Land and Water Resources

P. O. Box 10631
Jackson, MS 39289-0631
WATER WELL DRILLERS LOG

COUNTY WELL LOCATED Jackson	
WELL NUMBER 2377	CODR#
DATE WELL COMPLETED 12-18-93	

PERMIT NUMBER
NAME OF DRILLING FIRM Pierce Well

NAME & MAILING ADDRESS OF LANDOWNER Martha Ates		
Vanleave, MS		
WELL LOCATION: SEC	TOWNSHIP	RANGE
11	6 S	8 E
DISTANCE	DIRECTION	NEAREST TOWN
4 Miles	N	of Vanleave
OTHER LANDMARK		
WELL PURPOSE: <input checked="" type="checkbox"/> Home Irrigation, <input type="checkbox"/> Municipal, <input type="checkbox"/> Industrial, <input type="checkbox"/> Fish Pond, etc.		

PUMP DATA		
PUMP TYPE (Circle One): Submersible, Turbine, <input checked="" type="radio"/> Jet, Flowing Well, Other (Describe) _____		
POWER TYPE (Circle One): <input checked="" type="radio"/> Electric, Tractor, Diesel, Gasoline, Butane, Other (Describe) _____ H/P 1		
Pump Capacity (GPM)	No. of Stages	Setting Depth
10	2	60 FT.
PUMP TEST		
Well yielded 10 GPM with a drawdown of 10 ft. after 1 hours of pumping		

WELL DATA		
Well Depth 140'	Casing Diameter (In.) 2"	Casing Length (Ft.) 130'
Type of Casing Plastic	Hole Depth 140'	Depth to Static Water Level 60'
TYPE OF COMPLETION: (Circle One or More): <input checked="" type="checkbox"/> Gravel Packed, <input type="checkbox"/> Underreamed, <input type="checkbox"/> Telescoped, <input checked="" type="checkbox"/> Natural Development, <input type="checkbox"/> Open Hole, <input type="checkbox"/> Other (Describe) _____		
WELL GROUTED TO A DEPTH OF _____ FEET Type Grout (circle one): Cement, Bentonite, or Mix		

LOG DATA	
TYPE OF LOG RUN (Circle One): <input checked="" type="radio"/> No Log Run, Electric, Gamma Ray, Density, Sonic, Neutron, Other (Describe) _____	
Name of Organization Running Log	

SCREEN DATA		
Diameter - Inches 2"	Length - Feet 10'	Slot Size - Inches 006
Screen Type Plastic		Depth to Bottom - Feet 140'

GEOLOGIC DATA (Office Use Only)			
Surface Elev.	Geologic Unit	Unit Thickness	Depth to Top
Subs. SWL	Date	Analysis	Aquifer Test

Driller's Remarks


DESCRIPTION OF FORMATIONS ENCOUNTERED	FROM	TO
TDP Soil	0	10
Clay	10	20
Sand + Clay	20	100
Good Sand	100	140

FORMATIONS (Continued)	FROM	TO
RECEIVED		
MAR 02 1994		
Dept. of Environmental Quality Office of Land & Water Resources		

IF MORE SPACE IS NEEDED, USE BACK

If well telescopes please sketch and show depths.


GROUND LEVEL

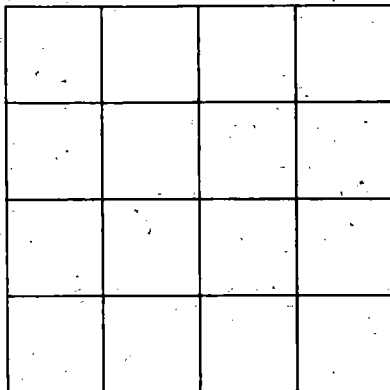

SECTION _____

Please indicate well location X.

ADDITIONAL INFORMATION

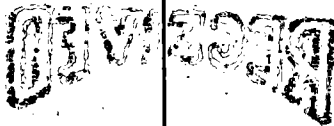

NOV 10 1964

PLEASE PRINT NAME AND ADDRESS OF OWNER OF WELL AND OF WELL LOGGERS

If more than one screen, show location of each on sketch.