

MISSISSIPPI DEPARTMENT OF ENVIRONMENTAL QUALITY

Office of Land and Water Resources

P. O. Box 10631

Jackson, MS 39289-0631

WATER WELL DRILLERS LOG

| | |
|---------------------------------------|-------|
| COUNTY WELL LOCATED <i>Jackson</i> | |
| WELL NUMBER <i>2390</i> | CODED |
| DATE WELL COMPLETED <i>8-1-94</i> | |

| |
|--|
| PERMIT NUMBER |
| NAME OF DRILLING FIRM <i>Coast Water Well Service</i> |

| | | | |
|---|-----------------------|--------------------------------|-------|
| NAME & MAILING ADDRESS OF LANDOWNER <i>Rodney Hoff Meadows Glen Rd. Vandave</i> | | | |
| WELL LOCATION | SEC <i>10</i> | TOWNSHIP <i>6 N 8 W</i> | RANGE |
| DISTANCE <i>5</i> Miles | DIRECTION <i>W</i> | NEAREST TOWN <i>VANDAVE</i> | |
| OTHER LANDMARK | | | |
| WELL PURPOSE: <input checked="" type="checkbox"/> Home Irrigation, Municipal, Industrial, Fish Pond, etc. | | | |

| | | |
|--|---------------------------|----------------------------|
| PUMP DATA | | |
| PUMP TYPE (Circle One): Submersible, Turbine, <input checked="" type="radio"/> Jet, Flowing Well, Other (Describe) _____ | | |
| POWER TYPE (Circle One): <input checked="" type="radio"/> Electric, Tractor, Diesel, Gasoline, Butane, Other (Describe) _____ H/P <i>1</i> | | |
| Pump Capacity (GPM) <i>10</i> | No. of Stages <i>2</i> | Setting Depth _____ FT. |
| PUMP TEST | | |
| Well yielded _____ GPM with a drawdown of _____ ft. after _____ hours of pumping | | |

| | | |
|------------------------------|------------------------------------|---|
| WELL DATA | | |
| Well Depth <i>63'</i> | Casing Diameter (In.) <i>2"</i> | Casing Length (Ft.) <i>58'</i> |
| Type of Casing <i>PVC</i> | Hole Depth <i>63'</i> | Depth to Static Water Level <i>20'</i> |

| | |
|---|--|
| LOG DATA | |
| TYPE OF LOG RUN (Circle One): Electric, Gamma Ray, Density, Sonic, <input checked="" type="radio"/> No Log Run, Neutron, Other (Describe) _____ | |
| Name of Organization Running Log | |

| | | | |
|---|--|--|--|
| TYPE OF COMPLETION: (Circle One or More): <input checked="" type="checkbox"/> Gravel Packed, <input type="checkbox"/> Underreamed, <input type="checkbox"/> Telescoped, <input checked="" type="checkbox"/> Natural Development, <input type="checkbox"/> Open Hole, <input type="checkbox"/> Other (Describe) _____ | | | |
| WELL GROUTED TO A DEPTH OF <i>20</i> FEET Type Grout (circle one): <input checked="" type="checkbox"/> Cement, <input type="checkbox"/> Bentonite, or Mix | | | |

| | | | |
|---------------------------------|---------------|----------------|--------------|
| GEOLOGIC DATA (Office Use Only) | | | |
| Surface Elev. | Geologic Unit | Unit Thickness | Depth to Top |
| Subs. SWL | Date | Analysis | Aquifer Test |

| | | |
|--------------------------------|--------------------------------------|-----------------------------------|
| SCREEN DATA | | |
| Diameter - Inches <i>2"</i> | Length - Feet <i>5'</i> | Slot Size - Inches <i>.008</i> |
| Screen Type <i>PVC</i> | Depth to Bottom - Feet <i>63'</i> | |

| | |
|--|--|
| Driller's Remarks | |
| Top of Lap Pipe or Reduction in Casing | |
| FEET | IF TELESCOPED OR MORE THAN ONE SCREEN: USE BACK PAGE |

| DESCRIPTION OF FORMATIONS ENCOUNTERED | FROM | TO | FORMATIONS (Continued) | FROM | TO |
|---------------------------------------|-----------|-----------|------------------------|------|----|
| <i>Topsoil</i> | <i>0</i> | <i>2</i> | | | |
| <i>Red Med. sand</i> | <i>2</i> | <i>18</i> | | | |
| <i>Blue Clay</i> | <i>18</i> | <i>30</i> | | | |
| <i>White Med. sand</i> | <i>30</i> | <i>63</i> | | | |
| | | | | | |
| | | | | | |
RECEIVED


SEP 21 1994

Dept. of Environmental Quality
Office of Land & Water Resources

IF MORE SPACE IS NEEDED, USE BACK

If well telescopes please sketch and show depths.


GROUND LEVEL

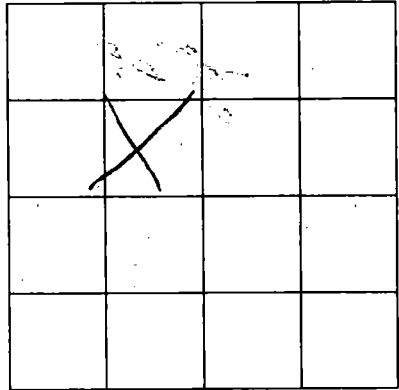

SECTION 10

Please indicate well location X.

ADDITIONAL INFORMATION

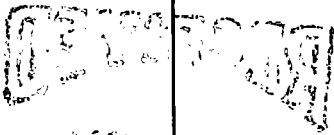

NOV 11 1954

U.S. GEOLOGICAL SURVEY
WATER RESOURCES DIVISION

If more than one screen,
show location of each on sketch.