

MISSISSIPPI DEPARTMENT OF ENVIRONMENTAL QUALITY
Office of Land and Water Resources

P. O. Box 10631
 Jackson, MS 39289-0631
WATER WELL DRILLERS LOG

COUNTY WELL LOCATED <i>Jackson</i>	
WELL NUMBER <i>J 2944</i>	CODED
DATE WELL COMPLETED <i>12-1-95</i>	

PERMIT NUMBER
NAME OF DRILLING FIRM <i>Coast Water Well Service</i>

NAME & MAILING ADDRESS OF LANDOWNER <i>Wayne Cumberland</i>
<i>Meadowglens Rd.</i>
<i>Vanclave, Ms.</i>

PUMP DATA		
PUMP TYPE (Circle One): Submersible, Turbine, <input checked="" type="radio"/> Jet, Flowing Well, Other (Describe) _____		
POWER TYPE (Circle One): <input checked="" type="radio"/> Electric, Tractor, Diesel, Gasoline, Butane, Other (Describe) _____ H/P <u>1</u>		

WELL LOCATION: SEC	TOWNSHIP	RANGE
<i>10</i>	<i>6</i>	<i>8</i>

Pump Capacity (GPM)	No. of Stages	Setting Depth
<i>10</i>	<i>2</i>	FT.

DISTANCE	DIRECTION	NEAREST TOWN
<i>5</i> Miles	<i>West</i>	of <i>Vanclave</i>

PUMP TEST	
Well yielded _____ GPM with	a drawdown of _____ ft.
after _____ hours of pumping	

OTHER LANDMARK
WELL PURPOSE <input checked="" type="radio"/> Home Irrigation, Municipal, Industrial, Fish Pond, etc.

WELL DATA		
Well Depth <i>65'</i>	Casing Diameter (In.) <i>2"</i>	Casing Length (Ft.) <i>60'</i>
Type of Casing <i>PVC</i>	Hole Depth <i>65'</i>	Depth to Static Water Level <i>18'</i>

LOG DATA	
TYPE OF LOG RUN (Circle One): Electric, Gamma Ray, Density, Sonic, Neutron, Other (Describe) _____ <input checked="" type="radio"/> No Log Run	
Name of Organization Running Log	

TYPE OF COMPLETION: (Circle One or More): Gravel Packed, Underreamed, Telescoped, Natural Development, Open Hole, Other (Describe) _____			
---	--	--	--

GEOLOGIC DATA (Office Use Only)			
Surface Elev.	Geologic Unit	Unit Thickness	Depth to Top
Subs. SWL	Date	Analysis	Aquifer Test

WELL GROUTED TO A DEPTH OF <u><i>20</i></u> FEET Type Grout (circle one): Cement, Bentonite, or Mix
--


SCREEN DATA		
Diameter - Inches <i>2"</i>	Length - Feet <i>5'</i>	Slot Size - Inches <i>.008</i>
Screen Type <i>PVC</i>	Depth to Bottom - Feet <i>65'</i>	

Driller's Remarks

DESCRIPTION OF FORMATIONS ENCOUNTERED	FROM	TO	FORMATIONS (Continued)	FROM	TO
<i>Top Soil</i>	<i>0</i>	<i>2</i>	<i>JAN 29 1996</i>		
<i>Orange-grey clay</i>	<i>2</i>	<i>22</i>			
<i>Coarse sand</i>	<i>22</i>	<i>65</i>			
			Dept. of Environmental Quality Office of Land and Water Resources		
IF MORE SPACE IS NEEDED, USE BACK					

If well telescopes please sketch and show depths.

GROUND LEVEL

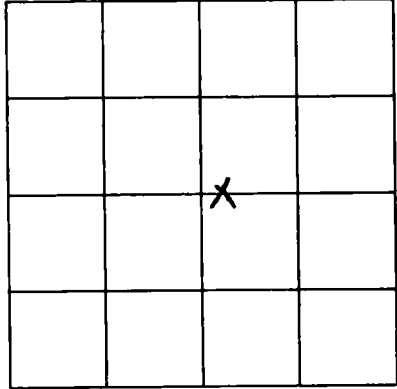

SECTION 10

Please indicate well location X.

ADDITIONAL INFORMATION

If more than one screen,
show location of each on sketch.