

MISSISSIPPI DEPARTMENT OF ENVIRONMENTAL QUALITY

Office of Land and Water Resources

P. O. Box 10631
Jackson, MS 39289-0631
WATER WELL DRILLERS LOG

COUNTY WELL LOCATED <i>Jackson</i>	
WELL NUMBER <i>J 2556</i>	CODED
DATE WELL COMPLETED <i>1-3-97</i>	

PERMIT NUMBER
NAME OF DRILLING FIRM <i>Coast Water Well Service</i>

NAME & MAILING ADDRESS OF LANDOWNER <i>Robert Lucas Q-14 Foxridge Rd. Vandevore, Ms. 39565</i>			
WELL LOCATION	SEC	TOWNSHIP	RANGE
	<i>8</i>	<i>6</i>	<i>8</i>
DISTANCE <i>0.7</i> Miles	DIRECTION <i>West</i>	NEAREST TOWN <i>Vandevore</i>	
OTHER LANDMARK			
WELL PURPOSE <input checked="" type="checkbox"/> Home, <input type="checkbox"/> Irrigation, <input type="checkbox"/> Municipal, <input type="checkbox"/> Industrial, <input type="checkbox"/> Fish Pond, etc.			

PUMP DATA		
PUMP TYPE (Circle One): Submersible, Turbine, <input checked="" type="radio"/> Flowing Well, Other (Describe) _____		
POWER TYPE (Circle One): <input checked="" type="radio"/> Electric, Tractor, Diesel, Gasoline, Butane, Other (Describe) _____ H/P <i>1</i>		
Pump Capacity (GPM) <i>12</i>	No. of Stages <i>2</i>	Setting Depth FT.
PUMP TEST		
Well yielded _____ GPM with a drawdown of _____ ft. after _____ hours of pumping		

WELL DATA		
Well Depth <i>194'</i>	Casing Diameter (In.) <i>2"</i>	Casing Length (Ft.) <i>184'</i>
Type of Casing <i>PVC</i>	Hole Depth <i>194'</i>	Depth to Static Water Level <i>30'</i>
TYPE OF COMPLETION: (Circle One or More): <input checked="" type="checkbox"/> Gravel Packed, <input type="checkbox"/> Underreamed, <input type="checkbox"/> Telescoped, <input checked="" type="checkbox"/> Natural Development, <input type="checkbox"/> Open Hole, <input type="checkbox"/> Other (Describe) _____		
WELL GROUTED TO A DEPTH OF <i>20</i> FEET Type Grout (circle one): <input checked="" type="radio"/> Cement, <input type="radio"/> Bentonite, <input type="radio"/> or Mix		

LOG DATA	
TYPE OF LOG RUN (Circle One): Electric, Gamma Ray, Density, Sonic, Neutron, Other (Describe) _____	
Name of Organization Running Log	

SCREEN DATA		
Diameter - Inches <i>2"</i>	Length - Feet <i>10'</i>	Slot Size - Inches <i>.004</i>
Screen Type <i>PVC Wrapped</i>	Depth to Bottom - Feet <i>194'</i>	


GEOLOGIC DATA (Office Use Only)			
Surface Elev.	Geologic Unit	Unit Thickness	Depth to Top
Subs. SWL	Date	Analysis	Aquifer Test
Driller's Remarks			
Top of Lap Pipe or Reduction in Casing			
FEET		IF TELESCOPED OR MORE THAN ONE SCREEN: USE BACK PAGE	

DESCRIPTION OF FORMATIONS ENCOUNTERED	FROM	TO
<i>Top Soil</i>	<i>0</i>	<i>2</i>
<i>White Clay</i>	<i>2</i>	<i>30</i>
<i>Mixed White Sand</i>	<i>30</i>	<i>44</i>
<i>Blue Clay</i>	<i>44</i>	<i>55</i>
<i>White Coarsened</i>	<i>55</i>	<i>65</i>
<i>Blue Clay</i>	<i>65</i>	<i>170</i>
<i>Fine gray Sand</i>	<i>170</i>	<i>194</i>

RECEIVED	
MAR 06 1997	
Dept. of Environmental Quality Office of Land & Water Resources	
IF MORE SPACE IS NEEDED USE BACK	

If well telescopes please
sketch and show depths.

GROUND LEVEL

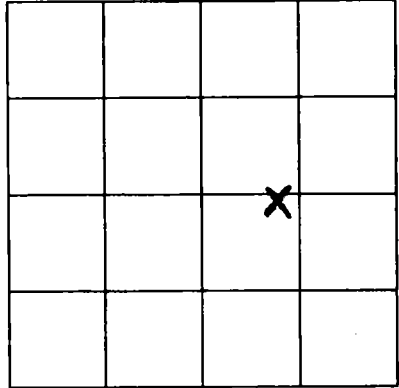

SECTION 8

Please indicate well location X.

ADDITIONAL INFORMATION

Lined area for additional information.

If more than one screen,
show location of each on sketch.