

MISSISSIPPI DEPARTMENT OF ENVIRONMENTAL QUALITY

Office of Land and Water Resources

P. O. Box 10631
Jackson, MS 39289-0631
WATER WELL DRILLERS LOG

COUNTY WELL LOCATED Jackson	
WELL NUMBER J 2604	CODED
DATE WELL COMPLETED 9-16-97	

PERMIT NUMBER
NAME OF DRILLING FIRM Coast Water Well Service

NAME & MAILING ADDRESS OF LANDOWNER Robert Lucas V-8 Southern Pine Drive Vandevan, Ms			
WELL LOCATION	SEC	TOWNSHIP	RANGE
	9	6 N	8 E
DISTANCE	DIRECTION	NEAREST TOWN	
6 Miles	West	of Vandevan	
OTHER LANDMARK			
WELL PURPOSE (Home, Irrigation, Municipal, Industrial, Fish Pond, etc.) <input checked="" type="radio"/> Home			

PUMP DATA		
PUMP TYPE (Circle One): Submersible, Turbine, <input checked="" type="radio"/> Jet <input type="radio"/> Flowing Well, Other (Describe) _____		
POWER TYPE (Circle One): <input checked="" type="radio"/> Electric <input type="radio"/> Tractor, Diesel, Gasoline, Butane, Other (Describe) _____ H/P <input type="radio"/>		
Pump Capacity (GPM) 8	No. of Stages 2	Setting Depth FT.
PUMP TEST Well yielded _____ GPM with a drawdown of _____ ft. after _____ hours of pumping		

WELL DATA		
Well Depth 262'	Casing Diameter (In.) 2"	Casing Length (Ft.) 252'
Type of Casing PVC	Hole Depth 262'	Depth to Static Water Level 50'

TYPE OF COMPLETION: (Circle One or More):
 Gravel Packed, Underreamed, Telescoped,
 Natural Development, Open Hole, Other

WELL GROUTED TO A DEPTH OF **30** FEET
 Type Grout (circle one): Cement, Bentonite, or Mix

SCREEN DATA		
Diameter - Inches 2"	Length - Feet 10'	Slot Size - Inches .004
Screen Type PVC Wrapped	Depth to Bottom - Feet 262'	

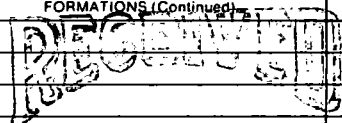
LOG DATA	
TYPE OF LOG RUN (Circle One): Electric, Gamma Ray, Density, Sonic, <input checked="" type="radio"/> No Log Run, Neutron, Other (Describe) _____	
Name of Organization Running Log	

GEOLOGIC DATA (Office Use Only)			
Surface Elev.	Geologic Unit	Unit Thickness	Depth to Top
Subs. SWL	Date	Analysis	Aquifer Test

Driller's Remarks

Top of Lap Pipe or Reduction in Casing

FEET IF TELESCOPED OR MORE THAN ONE SCREEN: USE BACK PAGE

DESCRIPTION OF FORMATION ENCOUNTERED	FROM	TO	FORMATIONS (Continued)	FROM	TO
Top Soil	0	2'	 JUL 21 1997 Dept. of Environmental Quality Office of Land & Water Resources		
Brown Clay	2	41			
gray med sand	41	60			
Blue Clay	60	220			
gray med sand	220	262			

IF MORE SPACE IS NEEDED, USE BACK

