

MISSISSIPPI DEPARTMENT OF ENVIRONMENTAL QUALITY
Office of Land and Water Resources

P. O. Box 10631

Jackson, MS 39289-0631

WATER WELL DRILLERS LOG

COUNTY WELL LOCATED
Jackson
WELL NUMBER
J 2668
CODED
DATE WELL COMPLETED
2-25-98

PERMIT NUMBER
NAME OF DRILLING FIRM
Coast Water Well Service

NAME & MAILING ADDRESS OF LANDOWNER
Robert Lucas CC-6
Ridgeland Rd.
Vandeventer Dr
WELL LOCATION: SEC 15 TOWNSHIP 6^N RANGE 8^W
DISTANCE 5 Miles West of Vandeventer
OTHER LANDMARK
WELL PURPOSE: Home Irrigation, Municipal, Industrial, Fish Pond, etc.

PUMP DATA
PUMP TYPE (Circle One):
Submersible, Turbine, Jet, Flowing Well.
Other (Describe) _____
POWER TYPE (Circle One):
 Electric, Tractor, Diesel, Gasoline, Butane.
Other (Describe) _____ H/P 1
Pump Capacity (GPM) 7.5 No. of Stages 2 Setting Depth _____ FT.
PUMP TEST
Well yielded _____ GPM with
a drawdown of _____ ft.
after _____ hours of pumping

WELL DATA
Well Depth 263' Casing Diameter (In.) 2" Casing Length (Ft.) 253'
Type of Casing PVC Hole Depth 263' Depth to Static Water Level 60'
TYPE OF COMPLETION: (Circle One or More):
 Gravel Packed, Underreamed, Telescoped, Natural Development, Open Hole, Other
(Describe) _____
WELL GROUTED TO A DEPTH OF 20 FEET
Type Grout (circle one): Cement, Bentonite, or Mix

LOG DATA
TYPE OF LOG RUN (Circle One):
Electric, Gamma Ray, Density, Sonic, No Log Run, Neutron.
Other (Describe) _____
Name of Organization Running Log

SCREEN DATA
Diameter - Inches 2" Length - Feet 10' Slot Size - Inches .004
Screen Type PVC Wrapped Depth to Bottom - Feet 263'

GEOLOGIC DATA (Office Use Only)

Surface Elev.	Geologic Unit	Unit Thickness	Depth to Top
Subs. SWL	Date	Analysis	Aquifer Test

Driller's Remarks

Top of Lap Pipe or Reduction in Casing

FEET IF TELESCOPED OR MORE THAN ONE SCREEN: USE BACK PAGE


DESCRIPTION OF FORMATION ENCOUNTERED	FROM	TO	FORMATIONS (Continued)	FROM	TO
<u>Top Soil</u>	<u>0</u>	<u>2</u>			
<u>Blue Clay</u>	<u>2</u>	<u>42</u>			
<u>med gray sand</u>	<u>42</u>	<u>80</u>			
<u>Blue Clay</u>	<u>80</u>	<u>113</u>			
<u>Med gray sand</u>	<u>113</u>	<u>132</u>			
<u>Blue Clay</u>	<u>132</u>	<u>250</u>			
<u>Med gray sand</u>	<u>250</u>	<u>263</u>			

03-30-98A09:54 RCVD

IF MORE SPACE IS NEEDED, USE BACK

If well telescopes please sketch and show depths.

GROUND LEVEL

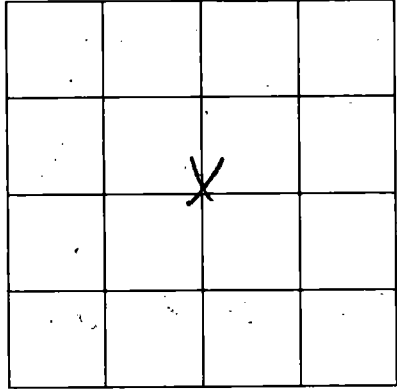

SECTION 15

Please indicate well location X.

ADDITIONAL INFORMATION

If more than one screen,
show location of each on sketch.