

MISSISSIPPI DEPARTMENT OF ENVIRONMENTAL QUALITY

Office of Land and Water Resources

P. O. Box 10631
Jackson, MS 39289-0631
WATER WELL DRILLERS LOG

COUNTY WELL LOCATED
Jackson

WELL NUMBER
J 2817

DATE WELL COMPLETED
3-12-99

PERMIT NUMBER

NAME OF DRILLING FIRM
Coast Water Well Service

NAME & MAILING ADDRESS OF LANDOWNER
**Robert Lucas LL-3
Bluebird Rd.
Vancelove, Ms**

WELL LOCATION: SEC _____ TOWNSHIP _____ RANGE _____
15 6 N 8 E W

DISTANCE _____ DIRECTION _____ NEAREST TOWN _____
5 1/2 Miles West of Vancelove

OTHER LANDMARK

WELL PURPOSE Home Irrigation, Municipal, Industrial, Fish Pond, etc.

PUMP DATA

PUMP TYPE (Circle One):
Submersible, Turbine, Jet, Flowing Well, Other (Describe) _____

POWER TYPE (Circle One):
 Electric, Tractor, Diesel, Gasoline, Butane, Other (Describe) _____
H/P **1**

Pump Capacity (GPM) **8** No. of Stages **2** Setting Depth _____ FT.

PUMP TEST
Well yielded _____ GPM with a drawdown of _____ ft. after _____ hours of pumping

WELL DATA

Well Depth 210'	Casing Diameter (In.) 2"	Casing Length (Ft.) 200'
Type of Casing PVC	Hole Depth 210'	Depth to Static Water Level 45'

TYPE OF COMPLETION: (Circle One or More):
 Gravel Packed, Underreamed, Telescoped, Natural Development, Open Hole, Other (Describe) _____

WELL GROUTED TO A DEPTH OF **20** FEET
Type Grout (circle one): Cement, Bentonite, or Mix

LOG DATA

TYPE OF LOG RUN (Circle One):
Electric, Gamma Ray, Density, Sonic, Neutron, Other (Describe) _____

Name of Organization Running Log

SCREEN DATA

Diameter - Inches 2"	Length - Feet 10'	Slot Size - Inches .004
Screen Type PVC Wrapped	Depth to Bottom - Feet 210'	

GEOLOGIC DATA (Office Use Only)

Surface Elev.	Geologic Unit	Unit Thickness	Depth to Top
Subs. SWL	Date	Analysis	Aquifer Test

Driller's Remarks

DESCRIPTION OF FORMATIONS ENCOUNTERED	FROM	TO
Top Soil	0	2
Brown Clay	2	35
White Coarse Sand	35	65
Blue Clay	65	200
Med. gray sand	200	210

FORMATIONS (Continued)	FROM	TO

RECEIVED


APR 12 1999

Dept. of Environmental Quality
Office of Land & Water Resources

IF MORE SPACE IS NEEDED, USE BACK

If well telescopes please
sketch and show depths.

GROUND LEVEL

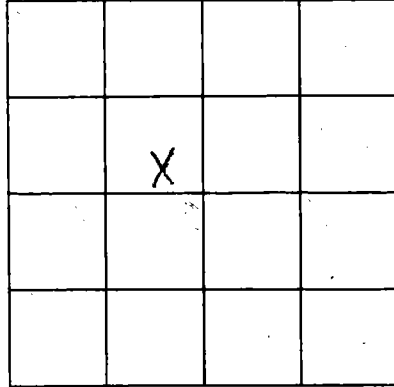

SECTION 15

Please indicate well location X.

ADDITIONAL INFORMATION

If more than one screen,
show location of each on sketch.