

MISSISSIPPI DEPARTMENT OF ENVIRONMENTAL

QUALITY

Office of Land and Water Resources

P. O. Box 10631

Jackson, MS 39289-0631

WATER WELL DRILLERS LOG

COUNTY WELL LOCATED
Jackson
 WELL NUMBER CODED
2867
 DATE WELL COMPLETED
3-28-99

PERMIT NUMBER
 NAME OF DRILLING FIRM
Coast Water Well Service

NAME & MAILING ADDRESS OF LANDOWNER
**Robert Lucas FE 19
 Foxman Drive
 Vanleave Ms**
 WELL LOCATION SEC TOWNSHIP RANGE
8 6 N 8 W
 DISTANCE DIRECTION NEAREST TOWN
7 1/2 Miles West of Vanleave
 OTHER LANDMARK
 WELL PURPOSE Home Irrigation, Municipal, Industrial, Fish Pond, etc.

PUMP DATA
 PUMP TYPE (Circle One):
 Submersible, Turbine, Jet, Flowing Well,
 Other (Describe) _____
 POWER TYPE (Circle One):
 Electric, Tractor, Diesel, Gasoline, Butane,
 Other (Describe) _____ H/P **1**
 Pump Capacity (GPM) No. of Stages Setting Depth
9 2 FT.
 PUMP TEST
 Well yielded _____ GPM with
 a drawdown of _____ ft.
 after _____ hours of pumping

WELL DATA
 Well Depth Casing Diameter (in) Casing Length (Ft)
100' 2" 90'
 Type of Casing Hole Depth Depth to Static Water Level
PVC 100' 30'

LOG DATA
 TYPE OF LOG RUN (Circle One):
 Electric, Gamma Ray, Density, Sonic, No Log Run, Neutron,
 Other (Describe) _____
 Name of Organization Running Log

TYPE OF COMPLETION (Circle One or More):
 Gravel Packed, Underreamed, Telescoped,
 Natural Development, Open Hole, Other
 (Describe) _____
 WELL GROUTED TO A DEPTH OF **2** FEET
 Type Grout (circle one): Cement, Bentonite, or Mix

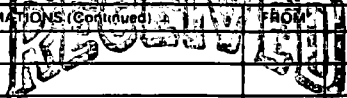
GEOLOGIC DATA (Office Use Only)

Surface Elev.	Geologic Unit	Unit Thickness	Depth to Top
Subs. SWL	Date	Analysis	Aquifer Test

SCREEN DATA
 Diameter - Inches Length - Feet Slot Size - Inches
2" 10' .004
 Screen Type Depth to Bottom - Feet
PVC Wrapped 100'

Driller's Remarks
 Top of Lap Pipe or Reduction in Casing
 FEET IF TELESCOPED OR MORE THAN ONE SCREEN: USE BACK PAGE

DESCRIPTION OF FORMATIONS ENCOUNTERED	FROM	TO
Top Soil	0	3
Orangeburg Clay	3	80
Fined to med sand	80	100

FORMATIONS (Continued) FROM TO

APR 12 1999
 Dept. of Environmental Quality
 Office of Land & Water Resources
 IF MORE SPACE IS NEEDED, USE BACK

If well telescopes please sketch and show depths.

GROUND LEVEL

	X		

SECTION 8

Please indicate well location X.

ADDITIONAL INFORMATION

If more than one screen,
show location of each on sketch.