

MISSISSIPPI DEPARTMENT OF ENVIRONMENTAL QUALITY

Office of Land and Water Resources

P. O. Box 10631  
Jackson, MS 39289-0631  
WATER WELL DRILLERS LOG

COUNTY WELL LOCATED  
*Jackson*

WELL NUMBER *52995* CODED

DATE WELL COMPLETED  
*11-2-99*

PERMIT NUMBER

NAME OF DRILLING FIRM  
*Coast Water Well Service*

NAME & MAILING ADDRESS OF LANDOWNER  
*Robert Lucas AI-2*

*Burgundy Drive*

*Vandover, Miss*

WELL LOCATION SEC TOWNSHIP RANGE  
*11 6 N 8 E*

DISTANCE DIRECTION NEAREST TOWN  
*4 Miles West of Vandover*

OTHER LANDMARK

WELL PURPOSE  Home  Irrigation, Municipal, Industrial, Fish Pond, etc.

PUMP DATA

PUMP TYPE (Circle One):  
Submersible, Turbine,  Flowing Well,  
Other (Describe)

POWER TYPE (Circle One):  
 Electric, Tractor, Diesel, Gasoline, Butane,  
Other (Describe) *H/P*

Pump Capacity (GPM) No. of Stages Setting Depth  
*7 2 FT.*

PUMP TEST

Well yielded \_\_\_\_\_ GPM with  
a drawdown of \_\_\_\_\_ ft.  
after \_\_\_\_\_ hours of pumping

WELL DATA

Well Depth <i>160'</i>	Casing Diameter (In.) <i>2"</i>	Casing Length (Ft.) <i>150'</i>
Type of Casing <i>PVC</i>	Hole Depth <i>160'</i>	Depth to Static Water Level <i>40'</i>

TYPE OF COMPLETION: (Circle One or More):  
 Gravel Packed,  Underreamed,  Telescoped,  
 Natural Development,  Open Hole,  Other  
(Describe)

WELL GROUTED TO A DEPTH OF *20* FEET  
Type Grout (circle one):  Cement,  Bentonite or Mix

LOG DATA

TYPE OF LOG RUN (Circle One):  No Log Run,  
Electric, Gamma Ray, Density, Sonic, Neutron,  
Other (Describe)

Name of Organization Running Log

SCREEN DATA

Diameter - Inches <i>2"</i>	Length - Feet <i>10'</i>	Slot Size - Inches <i>.004</i>
Screen Type <i>PVC Wrapped</i>	Depth to Bottom - Feet <i>160'</i>	

GEOLOGIC DATA (Office Use Only)

Surface Elev.	Geologic Unit	Unit Thickness	Depth to Top
Subs. SWL	Date	Analysis	Aquifer Test

Driller's Remarks

Top of Lap Pipe or Reduction in Casing


FEET IF TELESCOPED OR MORE THAN ONE SCREEN: USE BACK PAGE

DESCRIPTION OF FORMATIONS ENCOUNTERED	FROM	TO	FORMATIONS (Continued)	FROM	TO
<i>Top Soil</i>	<i>0</i>	<i>3</i>			
<i>Orange Red Clay</i>	<i>3</i>	<i>20</i>			
<i>Med. coarse sand</i>	<i>20</i>	<i>70</i>			
<i>Red Clay</i>	<i>70</i>	<i>106</i>			
<i>Med. coarse sand</i>	<i>106</i>	<i>160</i>			

IF MORE SPACE IS NEEDED, USE BACK

If well telescopes please  
sketch and show depths.

GROUND LEVEL

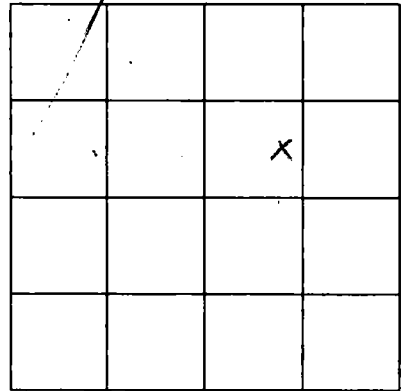

SECTION 11

Please indicate well location X.

ADDITIONAL INFORMATION

If more than one screen,  
show location of each on sketch.