


If well telescopes please sketch and show depths.

GROUND LEVEL

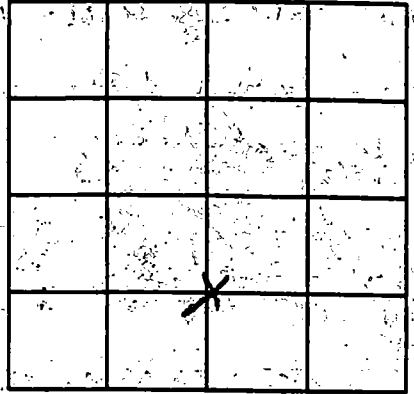

SECTION 7

Please indicate well location X.

ADDITIONAL INFORMATION

RECEIVED

JUN 8 2008

Office of Land & Water Resources
Dept. of Environmental Quality

If more than one screen,
show location of each on sketch.