

**MISSISSIPPI DEPARTMENT OF ENVIRONMENTAL QUALITY**  
Office of Land and Water Resources

P. O. Box 10631  
Jackson, MS 39289-0631  
**WATER WELL DRILLERS LOG**

COUNTY WELL LOCATED <i>Jackson</i>	
WELL NUMBER <i>J-3037</i>	CODED
DATE WELL COMPLETED <i>4-13-00</i>	

PERMIT NUMBER
NAME OF DRILLING FIRM <i>Coast Water Well Service</i>

NAME & MAILING ADDRESS OF LANDOWNER <i>Feb Casey</i> <i>Meadow Glen Rd.</i> <i>Vandeventer, Miss</i>			
WELL LOCATION	SEC	TOWNSHIP	RANGE
	<i>10</i>	<i>6<sup>N</sup></i>	<i>8<sup>W</sup></i>
DISTANCE	DIRECTION	NEAREST TOWN	
<i>5</i> Miles	<i>West</i>	<i>Vandeventer</i>	
OTHER LANDMARK			
WELL PURPOSE <input checked="" type="checkbox"/> Home Irrigation, Municipal, Industrial, Fish Pond, etc.			

PUMP DATA		
PUMP TYPE (Circle One): Submersible, Turbine, <input checked="" type="radio"/> Jet, Flowing Well, Other (Describe) _____		
POWER TYPE (Circle One): <input checked="" type="radio"/> Electric, Tractor, Diesel, Gasoline, Butane, Other (Describe) _____ M/P _____		
Pump Capacity (GPM) <i>8.5</i>	No of Stages <i>2</i>	Setting Depth _____ FT.
PUMP TEST		
Well yielded _____ GPM with a drawdown of _____ ft. after _____ hours of pumping		

WELL DATA		
Well Depth <i>68'</i>	Casing Diameter (in) <i>2"</i>	Casing Length (Ft) <i>10'</i>
Type of Casing <i>PVC</i>	Hole Depth <i>68'</i>	Depth to Static Water Level <i>12'</i>
TYPE OF COMPLETION: (Circle One or More): <input checked="" type="checkbox"/> Gravel Packed, <input checked="" type="checkbox"/> Underreamed, <input type="checkbox"/> Telescoped, <input checked="" type="checkbox"/> Natural Development, <input type="checkbox"/> Open Hole, <input type="checkbox"/> Other (Describe) _____		
WELL GROUTED TO A DEPTH OF <i>20</i> FEET Type Grout (circle one): <input checked="" type="radio"/> Cement, <input type="radio"/> Bentonite, or Mix		

LOG DATA	
TYPE OF LOG RUN (Circle One): Electric, Gamma Ray, Density, Sonic, <input checked="" type="radio"/> No Log Run, <input type="radio"/> Neutron Other (Describe) _____	
Name of Organization Running Log	

SCREEN DATA		
Diameter - inches <i>2"</i>	Length - Feet <i>10'</i>	Slot Size - inches <i>.004</i>
Screen Type <i>PVC Wrapped</i>	Depth to Bottom - Feet <i>68'</i>	


GEOLOGIC DATA (Office Use Only)			
Surface Elev	Geologic Unit	Unit Thickness	Depth to Top
Subs SWL	Date	Analysis	Aquifer Test
Driller's Remarks			
Top of Lap Pipe or Reduction in Casing			
IF TELESCOPED OR MORE THAN ONE SCREEN USE BACK PAGE			

DESCRIPTION OF FORMATIONS ENCOUNTERED	FROM	TO
<i>Top Soil</i>	<i>0</i>	<i>3</i>
<i>Oakumel Gray Clay</i>	<i>3</i>	<i>20</i>
<i>Mud. - 2 Coarse Sand</i>	<i>20</i>	<i>68</i>

FORM NO. 100-100-100	FROM	TO
<b>RECEIVED</b>		
JUL 12 2000		
Dept. of Environmental Quality Office of Land & Water Resources		
IF MORE SPACE IS NEEDED, USE BACK		

If well telescopes please sketch and show depths.

GROUND LEVEL

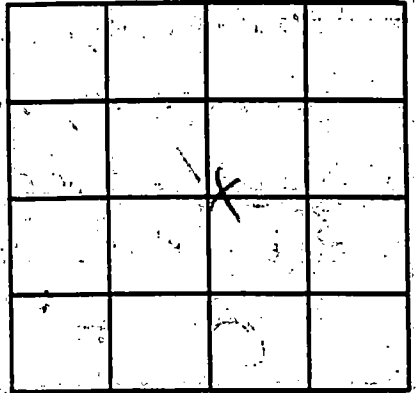

SECTION 10

Please indicate well location X.

ADDITIONAL INFORMATION

Multiple horizontal lines for additional information.

If more than one screen, show location of each on sketch.