


If well telescopes please sketch and show depths.

GROUND LEVEL

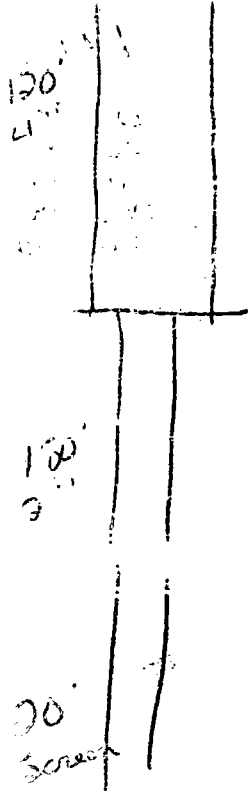

		X	

SECTION _____

Please indicate well location X.

Pump Capacity (GPM)	No. of Stages	Setting Depth
24	11	60' 00" FT.

PUMP TEST
 Well yielded 24 GPM with
 a drawdown of 15 ft.
 after 12 hours of pumping

LOG DATA

TYPE OF LOG RUN (Circle One):
 Electric, Gamma Ray, Density, Sonic, Neutron, Other (Describe) _____
No Log Run

Name of Organization Running Log _____

GEOLOGIC DATA (Office Use Only)

Surface Elev.	Geologic Unit	Unit Thickness	Depth to Top
Subs. SWL	Date	Analysis	Aquifer Test

Driller's Remarks

If more than one screen, show location of each on sketch.