

Jackson

MISSISSIPPI DEPARTMENT OF ENVIRONMENTAL QUALITY

Office of Land and Water Resources

P. O. Box 10631

Jackson, MS 39289-0631

WATER WELL DRILLERS LOG

COUNTY WELL LOCATED  
Jackson

WELL NUMBER  
J-3131

DATE WELL COMPLETED  
MARCH 13, 02

PERMIT NUMBER

NAME OF DRILLING FIRM  
M + M well

NAME & MAILING ADDRESS OF LANDOWNER  
Joe Dereck  
12008 Wiscovitch

Latitude:  
Longitude: Wescovitch

WELL LOCATION. SEC TOWNSHIP RANGE  
13 6 N 9 E

DISTANCE DIRECTION NEAREST TOWN  
2 Miles N of Latimer

OTHER LANDMARK  
End of Wiscovitch Rd

WELL PURPOSE: Home, Irrigation, Municipal, Industrial, Fish Pond, etc.

PUMP DATA

PUMP TYPE (Circle One):  
Submersible, Turbine,  Flowing Well,  
Other (Describe)

POWER TYPE (Circle One):  
 Electric, Tractor, Diesel, Gasoline, Butane,  
Other (Describe) H/P

DESCRIPTION OF FORMATIONS ENCOUNTERED	FROM	TO
ORANGE CLAY	0	15
White CLAY	15	40
Green CLAY	40	70
GRAY CLAY	70	115
SAND	115	125
Green clay	125	160
SAND	160	180
Green CLAY	180	420
SAND &	420	495
Rock		495

WELL DATA

Well Depth <u>2</u>	Casing Diameter (in.) <u>2</u>	Casing Length (Ft.) <u>485</u>
Type of Casing <u>PVC</u>	Hole Depth <u>495</u>	Depth to Static Water Level <u>40</u>

TYPE OF COMPLETION: (Circle One or More):  
Gravel Packed, Underreamed, Telescoped,  
 Natural Development, Open Hole, Other

WELL GROUTED TO A DEPTH OF 10 FEET  
Type Grout (circle one): Cement, Bentonite, or Mix

SCREEN DATA

Diameter - Inches <u>2</u>	Length - Feet <u>10</u>	Slot Size - Inches <u>.006</u>
Screen Type <u>PVC</u>	Depth to Bottom - Feet <u>485-495</u>	

RECEIVED

APR 30 2002

BY: OLWR

Top of Lap Pipe or Reduction in Casing

FEET  IF TELESCOPED OR MORE THAN ONE SCREEN: USE BACK PAGE

I certify that the well was drilled, constructed and completed in accordance with all applicable Requirements of the Mississippi Department of Environmental Quality and/or the Mississippi Department of Health regulations and state laws.


Ally Madden 0563  
Signature of Licensed Driller and License No.

April 29, 02  
Date

Additional Information Required On Back

If well telescopes please sketch and show depths.

GROUND LEVEL

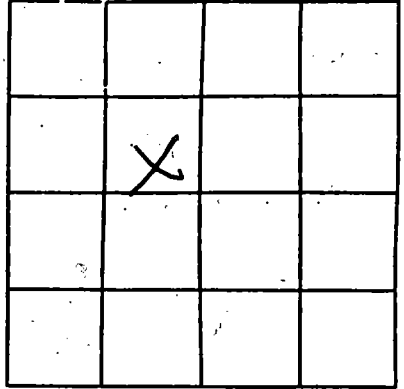

SECTION 13

Please indicate well location X.

Pump Capacity (GPM)	No. of Stages	Setting Depth
<u>9</u>	<u>2</u>	<u>60</u> FT.

PUMP TEST

Well yielded \_\_\_\_\_ GPM with  
a drawdown of \_\_\_\_\_ ft.  
after \_\_\_\_\_ hours of pumping

**LOG DATA**

TYPE OF LOG RUN (Circle One): No Log Run,  
Electric, Gamma Ray, Density, Sonic, Neutron,  
Other (Describe) \_\_\_\_\_

Name of Organization Running Log \_\_\_\_\_

**GEOLOGIC DATA (Office Use Only)**

Surface Elev.	Geologic Unit	Unit Thickness	Depth to Top
Subs. SWL	Date	Analysis	Aquifer Test

Driller's Remarks

If more than one screen,  
show location of each on sketch.