

MISSISSIPPI DEPARTMENT OF ENVIRONMENTAL QUALITY
Office of Land and Water Resources

P. O. Box 10631

Jackson, MS 39289-0631

WATER WELL DRILLERS LOG

COUNTY WELL LOCATED
Jackson

WELL NUMBER CODED
3134 ✓

DATE WELL COMPLETED
7-17-98

PERMIT NUMBER

NAME OF DRILLING FIRM
Coast Water Well Service

NAME & MAILING ADDRESS OF LANDOWNER
Kelly Davis
Jimi Ramsey Rd.
Latimer, Ms.

WELL LOCATION SEC TOWNSHIP RANGE
24 6 5 9 W

DISTANCE DIRECTION NEAREST TOWN
6 Miles *NORTH* of *Ocean Springs*

OTHER LANDMARK

WELL PURPOSE Irrigation, Municipal, Industrial, Fish Pond, etc.

PUMP DATA

PUMP TYPE (Circle One):
Submersible, Turbine, Jet, Flowing Well,
Other (Describe) _____

POWER TYPE (Circle One):
 Electric, Tractor, Diesel, Gasoline, Butane,
Other (Describe) _____ H/P *1*

Pump Capacity (GPM) No. of Stages Setting Depth
8 *2* _____ FT.

PUMP TEST
Well yielded _____ GPM with
a drawdown of _____ ft.
after _____ hours of pumping

WELL DATA

Well Depth Casing Diameter (in.) Casing Length (Ft.)
387' *2"* *377'*

Type of Casing Hole Depth Depth to Static Water Level
PVC *390'* *55'*

LOG DATA

TYPE OF LOG RUN (Circle One):
Electric, Gamma Ray, Density, Sonic, Neutron, Other (Describe) _____
 No Log Run

Name of Organization Running Log

TYPE OF COMPLETION: (Circle One or More):
 Gravel Packed, Underreamed, Telescoped,
 Natural Development, Open Hole, Other

GEOLOGIC DATA (Office Use Only)

Surface Elev.	Geologic Unit	Unit Thickness	Depth to Top
Subs. SWL	Date	Analysis	Aquifer Test

WELL GROUTED TO A DEPTH OF *20* FEET
Type Grout (circle one): Cement, Bentonite, or Mix

Driller's Remarks

07-23-98 9:44 AM

Top of Lap Pipe or Reduction in Casing

FEET IF TELESCOPED OR MORE THAN ONE SCREEN: USE BACK PAGE

SCREEN DATA

Diameter - Inches Length - Feet Slot Size - Inches
2" *10'* *.008*


Screen Type Depth to Bottom - Feet
PVC *390'*

DESCRIPTION OF FORMATIONS ENCOUNTERED	FROM TO		FORMATIONS (Continued)	FROM	TO
	FEET	FEET			
<i>Top Soil</i>	<i>0</i>	<i>3</i>			
<i>Orange gray clay</i>	<i>3</i>	<i>20</i>			
<i>Med sand</i>	<i>20</i>	<i>40</i>			
<i>gray Blue Clay</i>	<i>40</i>	<i>150</i>			
<i>fine med sand</i>	<i>150</i>	<i>200</i>			
<i>Blue Clay sh sand</i>	<i>200</i>	<i>365</i>			
<i>Med Coars sand</i>	<i>365</i>	<i>390</i>			

IF MORE SPACE IS NEEDED, USE BACK

If well telescopes please sketch and show depths.

GROUND LEVEL

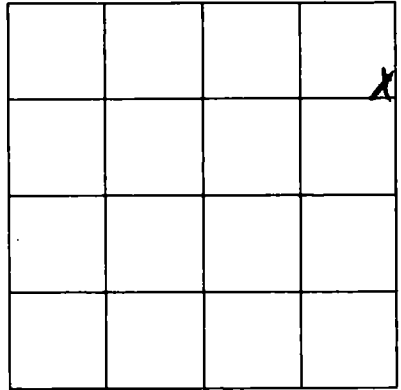

SECTION 24

Please indicate well location X.

ADDITIONAL INFORMATION

If more than one screen, show location of each on sketch.