

Jackson
J
8-67

MISSISSIPPI
BOARD OF WATER COMMISSIONERS
416 North State Street
Jackson, Mississippi 39201

CODED

WATER WELL DRILLERS LOG

Aug 14 1967 M & B Drilling Co Jackson
date well completed firm name county well located

LANDOWNER: Wayne Wostovich
P.O. Ocean Springs, Miss.
(mailing address)


description of formations encountered	from	to
Surface	0	10
White Clay	10	25
Sand	25	29
Blue Clay	29	60
Sand & Clay Breeds	60	70
Soft Grey Clay	70	100
Blue Clay	100	160
Coarse Sand	160	185
Blue Clay		

WELL LOCATION:
sec. 13 T. 6 S. R. 9 W.
7 miles N of Ocean Springs
(distance) (direction) (nearest town)

WELL PURPOSE: Home
(home, irrigation, municipal, industrial)

WELL COMPLETION DATA:
(1) diameter (inches) 2"
(2) total depth (feet) 190
(3) static water level (feet) 12 below top of ground.
(4) casing PVC 165 + 15 FT
(material) (depth) Tail Pipe
2" if telescope see back.
(size) 10 FT
(5) screen 165
(length) (depth to top)
2" PVC SandPac
(size) (material)
(6) pump 1 15
(HP) (yield gpm)
200 1/2 HP 1φ
(type power)
(7) electric log No
(yes or no)
No
(organization running log)
(8) how well bottom plugged PVC Cap


CODED

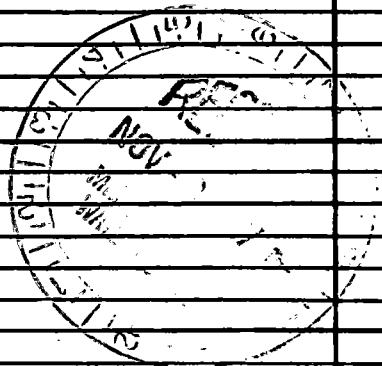

DRILLERS REMARKS:
Sears Roebuck Job

If well telescopes please sketch and show depths.

GROUND LEVEL

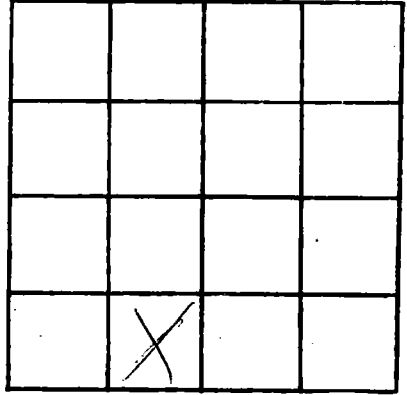

SE $\frac{1}{4}$ of SW $\frac{1}{4}$ SECTION 13

Please indicate well location X.

ADDITIONAL INFORMATION

If more than one screen, show locations of each on sketch.