

HANCOCK

MISSISSIPPI BOARD OF WATER COMMISSIONERS


K
3-3-65

WATER WELL DRILLERS LOG

K

Date: 3-3, 1965, Driller: Butter Well Works County Hancock
(Name)

(1) Owner of Land: <u>R. F. Patterson</u> (Name)	Description & Color of Materials Sand, Clay, Red Clay, Shell, etc.	Thick- ness Feet	Depth Feet
<u>1212 Josephine - New Orleans La</u> (Address)	<u>Clay</u>	<u>10</u>	<u>10</u>
	<u>sand</u>	<u>30</u>	<u>40</u>
(2) Location: <u>SE 1/4, SE 1/4, Sec. 12 T. 98 R. 15 W</u>	<u>Clay</u>	<u>22</u>	<u>62</u>
<u>6</u> miles <u>W</u> , of <u>Bay St Louis</u> (distance) (direction) (Nearest Town)	<u>sand</u>	<u>12</u>	<u>74</u>
(3) Topography: <u>flat</u> (Hilly) (Flat) (Level)	<u>Clay</u>	<u>11</u>	<u>85</u>
(4) Purpose of Well: <u>domestic</u> (Domestic Irrigation Municipal, Industrial, Other)	<u>sand</u>	<u>34</u>	<u>119</u>
Information upon completion of well:			
(1) Diameter <u>2</u> inches.			
(2) Total Depth <u>119</u> feet.			
(3) Water Level <u>11</u> feet below top of ground.			
(4) Cased to <u>all</u> , Size <u>2"</u>			
(5) Screen: Size <u>2"</u> , Length <u>5'</u>			
(6) Were any formations sealed against pollution?			
<u>no</u> yes, <input checked="" type="checkbox"/> no.			
If YES depth of formation _____			
Why _____			
Drillers Remarks: _____			

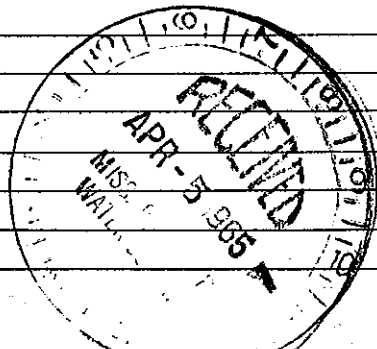

(Use-Back Side)

Well No.

Mail this copy to Board of Water Commissioners 429 Miss. St. Jackson, Miss.