

K43

WATER WELL DRILLERS LOG


Date: 7-10-61, 1961, Driller: L.P. Herland County Jackson
 34 (Name)

(1) Owner of Land: Mr. Rouse N.O.
 (Name)
Page Bayou
 (Address)
 (2) Location: SE 1/4, SW 1/4, Sec. 26 T6 S R2W
5 miles East of Veneleave
 (Distance) (direction) (Nearest Town)
 (3) Topography: Hilly (Flat) (Level)
 (4) Purpose of Well: Domestic Irrigation
 (Municipal, Industrial, Other)

Description & Color of Materials Sand, Clay, Red Clay, Shell, etc.	Thick- ness Feet	Depth Feet
Clay		21
Sand		42
"		63
8" Mud & Sand Str.		84
Sand		105
"		126
"		147
"		168
10' Sand 11' Mud		189
8" Mud		210
"		231
"		252
"		273
"		294
Fine Sand & Mud		315
8" Mud		336
"		357
"		378
"		399
"		420
18' Mud 3' Rock		441
Mud & Sand Str.		462
"		483
"		504
" & Sand Str.		525
Hard Shale		546
Mud		567
"		588
"		609
" & Sand Str.		630
Mud		651
19' Mud 2' Sand		672

Information upon completion of well:

(1) Diameter 2 inches.
 (2) Total Depth 1333 feet.
 (3) Water Level Flowed feet below top of ground.
 (4) Cased to _____, Size _____
 (5) Screen: Size 08, Length 20
 (6) Were any formations sealed against pollution?
 _____ yes, _____ no.

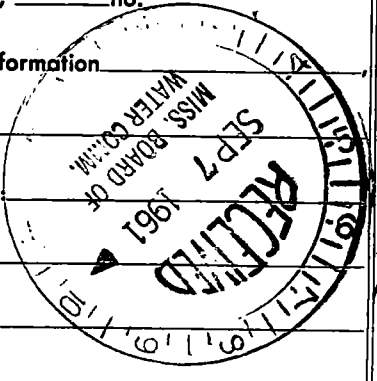

If YES depth of formation _____
 Why _____
 Drillers Remarks _____

(Use Back Side)

Well No.

