

JACKSON MISSISSIPPI BOARD OF WATER COMMISSIONERS

K 45
5-7-66

WATER WELL DRILLERS LOG

Date: 5-7, 1966, Driller: H. O. Riddell County Jackson

39
Mt. Pleasant
(1) Owner of Land: Methodist Church
(Name)
Vandevone, Miss.
(Address)

Description & Color of Materials Sand, Clay, Red Clay, Shell, etc.	Thick- ness Feet	Depth Feet
<u>Red Clay</u>	<u>10</u>	<u>10</u>
<u>pink vt</u>	<u>11</u>	<u>21</u>
<u>fine sand</u>	<u>36</u>	<u>57</u>

(2) Location: NW 1/4, NW 1/4, Sec. 12 T6R7
6 miles N. East, of Vandevone
(distance) (direction) (Nearest Town)

(3) Topography: ✓
(Hilly) (Flat) (Level)

(4) Purpose of Well: Church
(Domestic Irrigation
Municipal, Industrial, Other)


Information upon completion of well:

- (1) Diameter 2" inches.
- (2) Total Depth 57 feet.
- (3) Water Level 22 feet below top of ground.
- (4) Cased to _____, Size _____.
- (5) Screen: Size 1 1/4", Length 10'.
- (6) Were any formations sealed against pollution?
_____ yes, ✓ no.

If YES depth of formation _____

Why _____

Drillers Remarks: _____

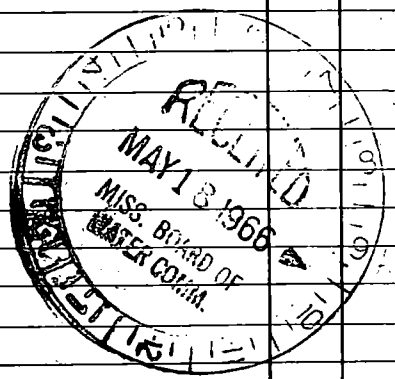

(Use Back Side)

Well No.

