

# WATER WELL DRILLERS LOG

**7-27-60**

Date: 7-26, 1960, Driller: C. J. Switzer Well Co. County Jackson

49

(Name)

(1) Owner of Land: Lester Mallett  
(Name)  
On Bluff Creek turn N. off Highway  
90 at Earl Bonds approx 8 miles.  
3 miles N. of Highway River crossing  
(Address) Camp

(2) Location: SW 1/4, SE 1/4, Sec. 38 T65R7N  
8 miles N.W., Pascogoula  
(distance) (direction) (Nearest Town)

(3) Topography:  (Hilly)  (Flat)  (Level)

(4) Purpose of Well: domestic  
(Domestic Irrigation Municipal, Industrial, Other)

| Description & Color of Materials<br>Sand, Clay, Red Clay, Shell, etc. | Thick-<br>ness<br>Feet | Depth<br>Feet |
|---|------------------------|---------------|
| Red Clay  | 0                      | 38            |
| Fine white sand   | 38                     | 47            |
| Blue Clay   | 47                     | 64            |
| white sand  | 64                     | 78            |
| Fine blue sand  | 78                     | 89            |
| Clay  | 89                     | 98            |
| sand-ox   | 98                     | 134           |
| Clay  | 134                    | 266           |
| sand  | 266                    | 277           |
| Clay  | 277                    | 286           |
| stratified  | 286                    | 294           |
| Clay  | 294                    | 467           |
| sand  | 467                    | 472           |
| Clay  | 472                    | 566           |
| sand-fair   | 566                    | 583           |
| Clay  | 583                    | 805           |
| sand-good   | 805                    | 819           |
| Clay  | 819                    | 864           |
| sand  | 864                    | 868           |
| rock  | 868                    | 869           |
| Clay  | 869                    | 1108          |
| sand-fair   | 1108                   | 1125          |
| Clay  | 1125                   | 1304          |
| sand-Med. good  | 1304                   | 1350          |

**Information upon completion of well:**

(1) Diameter 2" inches.

(2) Total Depth 1350' feet.

(3) Water Level 72'4" feet below top of ground.


(4) Cased to 1350', Size 2"

(5) Screen: Size 10 ga 55 Length 20'

(6) Were any formations sealed against pollution?  
 yes,  no.

If YES depth of formation 10 feet  
 Why Health Dept. Requirement

Drillers Remarks:

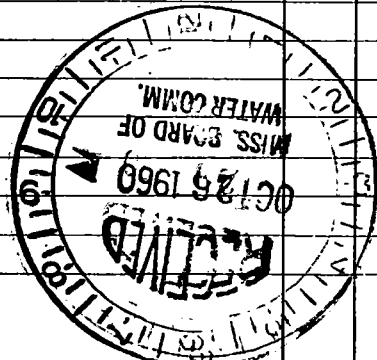

(Use Back Side)

