

# JACKSON MISSISSIPPI BOARD OF WATER COMMISSIONERS

K 47

## WATER WELL DRILLERS LOG

5-29-62

Date: May 29, 1962, Driller: L. L. Garland County Jackson  
(Name)

59

(1) Owner of Land: Scrap Mallette  
(Name)  
Fort Bayou  
(Address)

(2) Location: 1/4, 1/4, Sec 12 T6R7W  
(distance) miles (direction) of (Nearest Town)

(3) Topography: (Hills) (Flat) (Level)

(4) Purpose of Well: Dom.  
(Domestic Irrigation Municipal, Industrial, Other)

| Depth Feet | Description & Color of Materials<br>Sand, Clay, Red Clay, Shell, etc. | Thick-ness Feet |
|------------|-----------------------------------------------------------------------|-----------------|
| 1          |                                                                       |                 |
| 2          |                                                                       |                 |
| 3          |                                                                       |                 |
| 4          |                                                                       |                 |
| 5          |                                                                       |                 |
| 6          |                                                                       |                 |
| 7          |                                                                       |                 |
| 8          | 10' Sand & 3' Mud & 2' Sand                                           |                 |
| 9          | 10' " 11' 8" Mud                                                      |                 |
| 10         | Mud                                                                   |                 |
| 11         | "                                                                     |                 |
| 12         | "                                                                     |                 |
| 13         | Mud & Shale                                                           |                 |
| 14         | " "                                                                   |                 |
| 15         | " " & Sand Strips                                                     |                 |
| 16         | " "                                                                   |                 |
| 17         | " "                                                                   |                 |
| 18         | " "                                                                   |                 |
| 19         | " & Shale                                                             |                 |
| 20         | " "                                                                   |                 |
| 21         | " & Sand Strips                                                       |                 |
| 22         | Sand Strips & Rock                                                    |                 |
| 23         | " "                                                                   |                 |
| 24         | 10' Sand (Good)                                                       |                 |

Information upon completion of well:

(1) Diameter 2 inches.

(2) Total Depth 493 feet.

(3) Water Level 48 feet below top of ground.

(4) Cased to \_\_\_\_\_, Size \_\_\_\_\_


(5) Screen: Size 108, Length 10

(6) Were any formations sealed against pollution?  
 \_\_\_\_\_ yes, e no.

If YES depth of formation \_\_\_\_\_

Why \_\_\_\_\_

Drillers Remarks: \_\_\_\_\_

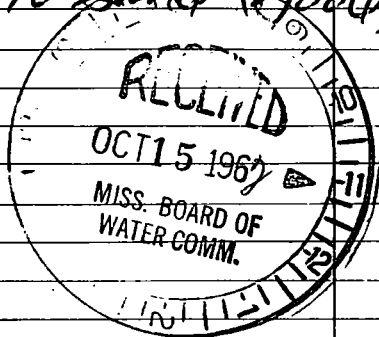

(Use Back Side)

Well No.

