

# JACKSON MISSISSIPPI BOARD OF WATER COMMISSIONERS

K 48

10-18-62

## WATER WELL DRILLERS LOG

Date: Oct. 18, 1962 Driller: L. L. Garland County Jackson

59

(1) Owner of Land: Mr. Mizell  
(Name)

Vareleave Miss.  
(Address)

(2) Location: 1/4, 1/4, Sec. 9 T6 R 7 W  
miles of  
(distance) (direction) (Nearest Town)

(3) Topography: (Flat)  
(Hilly) (Flat) (Level)

(4) Purpose of Well: Dom.  
(Domestic Irrigation  
Municipal, Industrial, Other)

Description & Color of Materials  
Sand, Clay, Red Clay, Shell, etc.

Thick-  
ness  
Feet

Depth  
Feet

1 Sand & Mud Strbs  
3 10' Sand 11' Mud  
4 19' Sand


### Information upon completion of well:

- (1) Diameter 2 inches.
- (2) Total Depth 81 feet.
- (3) Water Level 17 feet below top of ground.
- (4) Cased to \_\_\_\_\_, Size \_\_\_\_\_
- (5) Screen: Size .08, Length 10'
- (6) Were any formations sealed against pollution?  
\_\_\_\_ yes, \_\_\_\_ no.

If YES depth of formation \_\_\_\_\_

Why \_\_\_\_\_

Drillers Remarks: \_\_\_\_\_

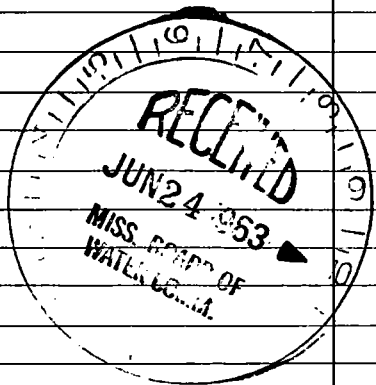

(Use Back Side)

Well No.

