

JACKSON MISSISSIPPI BOARD OF WATER COMMISSIONERS

K 49

10-23-62

WATER WELL DRILLERS LOG

Oct. 23 62

H. L. Farland

Jackson

Date: _____, 19____, Driller: _____ County: _____

54

(Name)

M. Helms

(1) Owner of Land: John R. Doncleave, Miss.

(Address) 1065 W

(2) Location: _____ 1/4, _____ 1/4, Sec. _____ T. R. _____

_____ miles (distance) _____ of _____ (Nearest Town)

(3) Topography: _____ (Hilly) _____ (Flat) _____ (Level)

(4) Purpose of Well: _____ (Domestic Irrigation Municipal, Industrial, Other)

Information upon completion of well:

(1) Diameter _____ inches

(2) Total Depth _____ feet

(3) Water Level _____ feet below top of ground.

(4) Cased to _____, Size _____

(5) Screen: Size _____, Length _____

(6) Were any formations sealed against pollution?


_____ yes, _____ no.

If YES depth of formation _____

Why _____

Drillers Remarks: _____

Description & Color of Materials Sand, Clay, Red Clay, Shell, etc.	Thick- ness Feet	Depth Feet
1 14' Clay 7' Sand		
2 Mix		
3 Sand		
4 Mix		
5 Mud		
6 Mix		
7 Mud		
8 "		
9 Mix		
10 "		
11 Mud		
12 Mix		
13 Sand		
14 10' Sand		

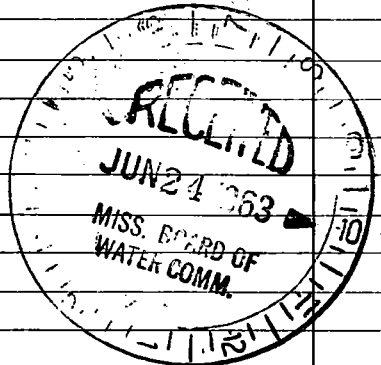

(Use Back Side)

Well No. _____

