

# JACKSON MISSISSIPPI BOARD OF WATER COMMISSIONERS

K 50

11-5-62

## WATER WELL DRILLERS LOG

Date: Nov. 5, 1962, Driller: L. L. Garland County Jackson

59

(Name)

(1) Owner of Land:	Description & Color of Materials Sand, Clay, Red Clay, Shell, etc.	Thick- ness Feet	Depth Feet
<u>Joe Bastin</u> (Name) <u>O. S. Miss.</u> (Address)	1 Clay		
(2) Location: $\frac{1}{4}$ , $\frac{1}{4}$ , Sec. <u>3</u> T <u>6</u> R <u>8</u> W	2 7' 14' Sand		
<u>2</u> miles <u>West</u> of <u>Van Cleve</u>	3 <u>mix.</u>		
(distance) (direction) (Nearest Town)	4 11' Mud 10' S.		
(3) Topography: (Hilly) (Flat) (Level)	5 19' S. 2' Mud		
(4) Purpose of Well: <u>Dom.</u> (Domestic Irrigation Municipal, Industrial, Other)	6 <u>mix.</u>		
	7 <u>Sand</u>		
	8 <u>Mud</u>		
	9 14' " 7' Sand		
	10 2' Sand 14' Mud		
	11 <u>Mud</u>		
	12 "		
	13 "		
	14 "		
	15 "		
	16 "		
	17 "		
	18 "		
	19 16' Mud 5' Sand		
	20 <u>Mixed</u>		
	21 <u>Shale</u>		
	22 " & S. S.		
	23 5' Shale 16' Sand		
	24 10' Sand		

Information upon completion of well:

(1) Diameter 2 inches.

(2) Total Depth 493 feet.

(3) Water Level 50 feet below top of ground.

(4) Cased to \_\_\_\_\_, Size \_\_\_\_\_.


(5) Screen: Size 08, Length 10'.

(6) Were any formations sealed against pollution?  
\_\_\_\_\_ yes, \_\_\_\_\_ no.

If YES depth of formation \_\_\_\_\_

Why \_\_\_\_\_

Drillers Remarks: \_\_\_\_\_

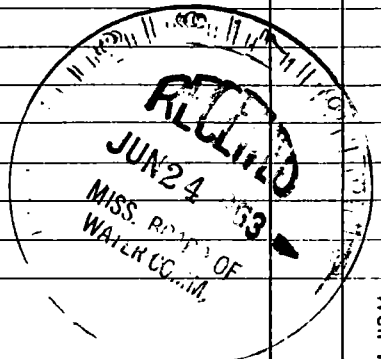

(Use Back Side)

Well No. \_\_\_\_\_

