


# JACKSON MISSISSIPPI BOARD OF WATER COMMISSIONERS

K 51

## 2-27-63 WATER WELL DRILLERS LOG

Date: Feb. 27, 1963, Driller: L. L. Garland County: Jackson  
 59 (Name)

(1) Owner of Land:	Description & Color of Materials Sand, Clay, Red Clay, Shell, etc.	Thick- ness Feet	Depth Feet
(Name) <u>Paul Carter</u> (Address) <u>Vanceave Miss.</u>	1 18' Clay	3'	Sand
(2) Location: _____ 1/4, _____ 1/4, Sec. <u>2 T. 15 N. R. 7 W.</u>	2 Sand		
<u>3</u> miles <u>NE</u> of <u>Vanceave</u> (distance) (direction) (Nearest Town)	3 Mix		
(3) Topography: <u>(Hilly)</u> (Flat) (Level)	4 Mud		
(4) Purpose of Well: <u>Dom.</u> (Domestic Irrigation Municipal, Industrial, Other)	5 "		
Information upon completion of well:	6 "		
(1) Diameter <u>2</u> inches.	7 Mix.		
(2) Total Depth <u>242</u> feet.	8 Mud		
(3) Water level <u>42</u> feet below top of ground.	9 "		
(4) Cased to _____, Size _____.	10 "		
(5) Screen: Size <u>.08</u> , Length <u>10'</u>	11 19' Mud	2'	Sand
(6) Were any formations sealed against pollution? _____ yes, _____ no.	12 11' Sand		
If YES depth of formation _____.			
Why _____.			
Drillers Remarks: _____			
_____			
_____			
_____			

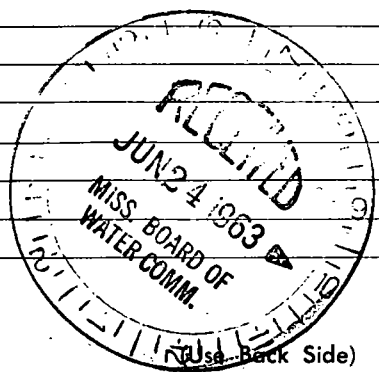

Well No. \_\_\_\_\_

