

K 52
7-15-65

WATER WELL DRILLERS LOG

Date: 7-15, 1965, Driller: Intert Well Works County Jackson
49 (Name)

(1) Owner of Land: <u>Bluff Creek School</u> (Name)	Description & Color of Materials Sand, Clay, Red Clay, Shell, etc.	Thick- ness Feet	Depth Feet
<u>Van Cleave, Miss.</u> (Address)	<u>sand</u>	<u>9</u>	<u>9</u>
(2) Location: <u>SW 1/4, SW 1/4, Sec. 4 T69R7W</u>	<u>Clay</u>	<u>31</u>	<u>40</u>
<u>1</u> miles <u>W</u> , of <u>Van Cleave</u> (distance) (direction) (Nearest Town)	<u>Clay - sand streaks</u>	<u>125</u>	<u>165</u>
(3) Topography: <u>hilly</u> (Hilly) (Flat) (Level)	<u>Clay</u>	<u>69</u>	<u>224</u>
(4) Purpose of Well: <u>School</u> (Domestic Irrigation Municipal, Industrial, Other)	<u>sand</u>	<u>53</u>	<u>277</u>
	<u>Clay</u>	<u>18</u>	<u>295</u>
	<u>sand</u>	<u>20</u>	<u>315</u>
	<u>Clay</u>	<u>1</u>	<u>316</u>


Information upon completion of well:

- (1) Diameter 3x2 inches.
- (2) Total Depth 316 feet.
- (3) Water Level 19 feet below top of ground. TOP 105' 4 3"
- (4) Cased to all, Size BA 4 2"
- (5) Screen: Size 2", Length 20'
- (6) Were any formations sealed against pollution?
 yes, no.

If YES depth of formation _____

Why _____

Drillers Remarks: _____

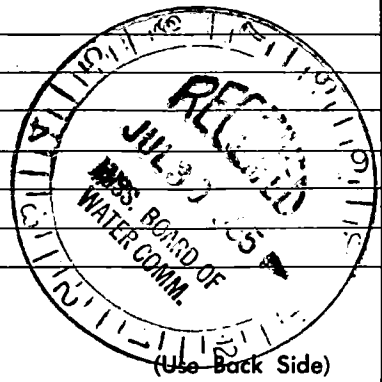

Well No. _____

