

49

MISSISSIPPI  
 BOARD OF WATER COMMISSIONERS  
 416 North State Street  
 Jackson, Mississippi 39201

WATER WELL DRILLERS LOG

5-1 1967 Coast Water Well Drillers Jackson  
 date well completed firm name county well located

LANDOWNER: Horace Wade  
Vandeventer, Miss.  
 (mailing address)

WELL LOCATION:  
 sec. 1 T 6 N R. 7 E  
                   S                  W  
5 miles NE of Vandeventer  
 (distance) (direction) (nearest town)


WELL PURPOSE: Home  
 (home, irrigation, municipal, industrial)

- WELL COMPLETION DATA:
- (1) diameter (inches) 2"
  - (2) total depth (feet) 178
  - (3) static water level (feet) 70 below above top of ground.
  - (4) casing 2" 168  
 (material) (depth)  
2"  
 (size) if telescope see back.
  - (5) screen 10 ft. 168  
 (length) (depth to top)  
2" Steel  
 (size) (material)
  - (6) pump 1 500  
 (HP) (yield gpm)  
Elect.  
 (type power)
  - (7) electric log NO  
 (yes or no)  
 (organization running log)

description of formations encountered	from	to
<u>Red Clay</u>	<u>0</u>	<u>69</u>
<u>Sand (Red) bed</u>	<u>69</u>	<u>84</u>
<u>Yellow clay</u>	<u>84</u>	<u>100</u>
<u>Blue clay</u>	<u>100</u>	<u>165</u>
<u>Sand (Red) bed</u>	<u>165</u>	<u>178</u>

(8) how well bottom plugged  
Back Wash Valve


DRILLERS REMARKS:

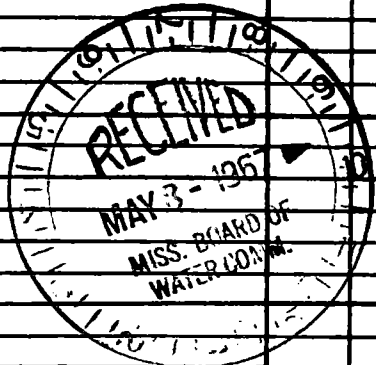

If well telescopes please sketch and show depths.

GROUND LEVEL

SE NW

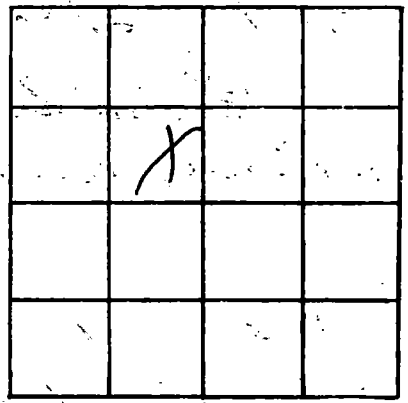

SECTION 1

Please indicate well location X.

ADDITIONAL INFORMATION

A series of horizontal lines for recording additional information, located below the 'ADDITIONAL INFORMATION' header.

If more than one screen, show locations of each on sketch.