

49


JACKSON
K54
8-67

MISSISSIPPI  
 BOARD OF WATER COMMISSIONERS  
 416 North State Street  
 Jackson, Mississippi 39201

WATER WELL DRILLERS LOG

Aug. 15 1967 Coast Water Well Service Jackson  
 date well completed firm name county well located

LANDOWNER	description of formations encountered	from	to
<u>Huff Creek Ind.</u> <u>Vandave Miss.</u>			
(mailing address)			
WELL LOCATION:			
sec <u>27</u> T <u>6</u> N R <u>2</u> E S                  W <u>4.5</u> miles <u>South</u> of <u>Merchessaw</u> (distance) (direction) (nearest town)			
WELL PURPOSE: <u>Industrial</u> (home, irrigation, municipal, industrial)			
WELL COMPLETION DATA:			
(1) diameter (inches) <u>Two</u>			
(2) total depth (feet) <u>54 ft.</u>			
(3) static water level (feet) <u>Five</u> below top of ground			
(4) casing <u>Galv.</u> <u>44 ft.</u> (material) (depth)			
<u>Two</u> If telescope see back. (size)			
(5) screen <u>Ten</u> <u>44 ft.</u> (length) (depth to top)			
<u>10 slot</u> <u>Stainless Steel</u> (size) (material)			
(6) pump <u>1</u> <u>25</u> (HP) (yield gpm)			
<u>Elect.</u> (type power)			
(7) electric log <u>no</u> (yes or no)			
<u>N. A.</u> (organization running log)			
(8) how well bottom plugged <u>Backwash valve</u>			
DRILLERS REMARKS:			

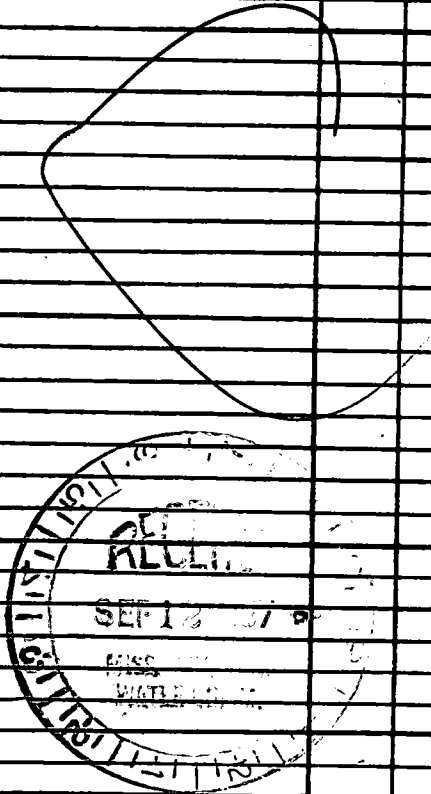

If well telescopes please sketch and show depths.

GROUND LEVEL

SWSE

		X	

SECTION 27

Please indicate well location X.

ADDITIONAL INFORMATION

If more than one screen, show locations of each on sketch.