

49

JACKSON
K55
8-67

MISSISSIPPI
BOARD OF WATER COMMISSIONERS
416 North State Street
Jackson, Mississippi 39201

WATER WELL DRILLERS LOG

Aug. 31 1967 Coast water well Service Jackson
date well completed firm name county well located

LANDOWNER: T. L. Murphy

description of formations encountered

from to

Route 2 Box 177 H
Ocean Springs, Miss.
~~Vandover Miss.~~
(mailing address)

Yellow clay	0	25
Fine white sand	25	35
Red sandy silt	35	100
Coarse sand	100	115


WELL LOCATION:

sec. 27 T 6 N R 7 E
S W
5 miles S. East of Vandover
(distance) (direction) (nearest town)

WELL PURPOSE: home
(home, irrigation, municipal, industrial)

WELL COMPLETION DATA:


- (1) diameter (inches) 2 in.
- (2) total depth (feet) 115 ft.
- (3) static water level (feet) 23 below top of ground.
- (4) casing Galv. 105 ft.
(material) (depth)
2 in. If telescope see back.
(size)
- (5) screen 10 ft. 105 ft.
(length) (depth to top)
10 slot plastic
(size) (material)
- (6) pump 1 (HP) 8 (yield gpm)
Elect. (type power)
- (7) electric log no
(yes or no)
H. & S.
(organization running log)
- (8) how well bottom plugged Back
wash valve

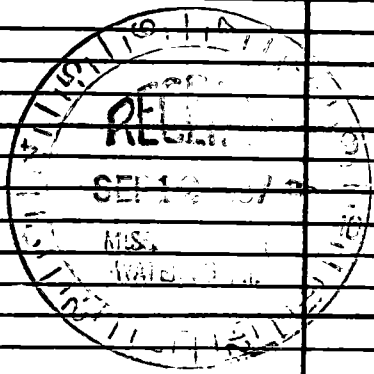

DRILLERS REMARKS:

If well telescopes please sketch and show depths.

GROUND LEVEL

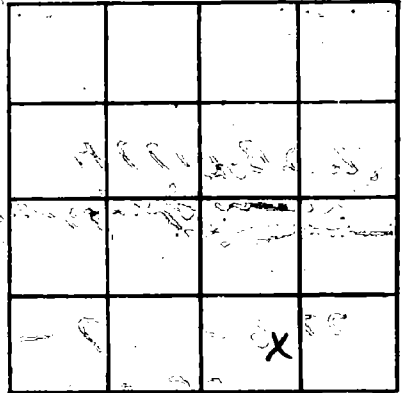

SECTION 27

Please indicate well location X.

ADDITIONAL INFORMATION

If more than one screen, show locations of each on sketch.