

49


JACKSON
1556
8-67

MISSISSIPPI  
BOARD OF WATER COMMISSIONERS  
416 North State Street  
Jackson, Mississippi 39201

WATER WELL DRILLERS LOG

Aug. 30 19 67 Coast water well Service Jackson  
date well completed firm name county well located


LANDOWNER:	description of formations encountered	from	to
T.L. Murphy	Yellow clay	0	15
Route 2 Box 177 H	Fine to medium sand	15	43
Ocean Springs Miss			
Vandeventer Miss.			
(mailing address)			
WELL LOCATION:			
sec 27 T 6 N R 7 E			
1 1/2 miles South E. of Vandeventer			
(distance) (direction) (nearest town)			
WELL PURPOSE: Home			
(home, irrigation, municipal, industrial)			
WELL COMPLETION DATA:			
(1) diameter (inches) 2"			
(2) total depth (feet) 43			
(3) static water level (feet) 8			
top of ground			
(4) casing plastic 38 ft.			
(material) (depth)			
2 in.			
(size) If telescope see back.			
(5) screen 5 ft. 38 ft.			
(length) (depth to top)			
2 in. plastic			
(size) (material)			
(6) pump 1/2 (HP) 8 (yield gpm)			
Elect.			
(type power)			
(7) electric log NO			
(yes or no)			
N. S.			
(organization running log)			
(8) how well bottom plugged back			
wash valve			
DRILLERS REMARKS:			

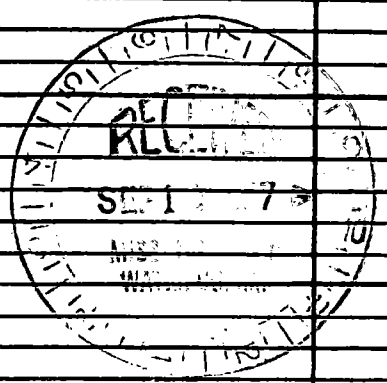

If well telescopes please sketch and show depths.

GROUND LEVEL

5N SE

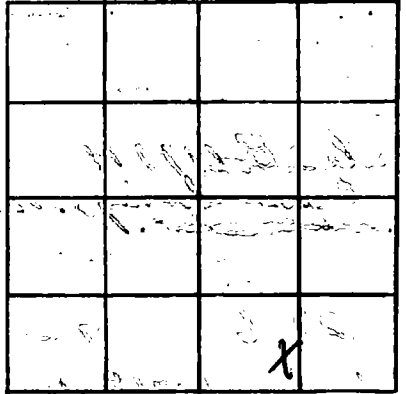

SECTION 27

Please indicate well location X.

ADDITIONAL INFORMATION

If more than one screen, show locations of each on sketch.