

**MISSISSIPPI
BOARD OF WATER COMMISSIONERS**
416 North State Street
Jackson, Mississippi 39201

CODED

WATER WELL DRILLERS LOG

6-15 1968
date well completed

Coast Water Well Serv.
firm name

Jackson
county well located

LANDOWNER: B.R. Fairley

Route 2 Box 364
Ocean Springs, Miss.
(mailing address)

description of formations
encountered

from to

<u>Red Clay + fine sand</u>	<u>0</u>	<u>21</u>
<u>White clay</u>	<u>21</u>	<u>42</u>
<u>Blue clay</u>	<u>42</u>	<u>100</u>
<u>Very fine sand</u>	<u>100</u>	<u>118</u>
<u>Blue clay + shale</u>	<u>118</u>	<u>148</u>
<u>Sand fine mud</u>	<u>148</u>	<u>178</u>

WELL LOCATION:

sec. 24 T. 6 S. R. 7 E. W.
4 miles S.E. of Vancleave
(distance) (direction) (nearest town)

WELL PURPOSE: Home
(home, irrigation, municipal, industrial)

WELL COMPLETION DATA:

- (1) diameter (inches) 2"
- (2) total depth (feet) 178
- (3) static water level (feet) 28 below
top of ground.
- (4) casing 2" galv., 173'
(material), (depth)
2"
(size) if telescope see back.
- (5) screen 5', 173'
(length), (depth to top)
2", Stainless Wrapped
(size), (material)
- (6) pump 1, 8
(HP), (yield gpm)
Elco
(type power)
- (7) electric log NO
(yes or no)

(organization running log)

- (8) how well bottom plugged Good
Wash valve


DRILLERS REMARKS:

DEC 10 1968

MISS. BD. OF
WATER COM.

If well telescopes please sketch and show depths.

GROUND LEVEL

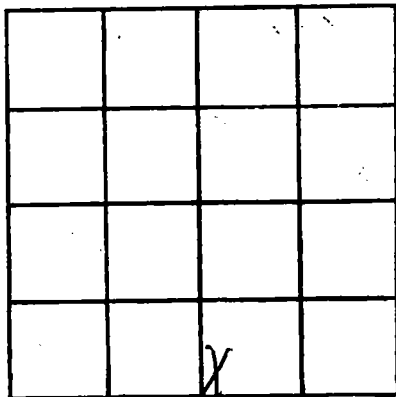

SECTION *24*

Please indicate well location X.

ADDITIONAL INFORMATION

If more than one screen, show locations of each on sketch.