

Jackson  
Klco  
11-30-64


MISSISSIPPI  
BOARD OF WATER COMMISSIONERS  
416 North State Street  
Jackson, Mississippi 39201

CODED

WATER WELL DRILLERS LOG


Nov 30 1964 Cahill Waterbury Jackson  
date well completed firm name county well located

LANDOWNER: Home of Grace	description of formations encountered	from	to
Paul Shaw Miss (mailing address)	sand	0	110
WELL LOCATION: sec. 17 T6 N R. 07 E 1 1/2 miles SW of Vandalia (distance) (direction) (nearest town)	clay	110	306
WELL PURPOSE: Domestic Home (home, irrigation, municipal, industrial)	sand	206	268
WELL COMPLETION DATA:	clay	268	358
(1) diameter (inches) 2	sand	358	365
(2) total depth (feet) 365			
(3) static water level (feet) 7 below top of ground			
(4) casing (material) (depth) (size) if telescope see back.			
(5) screen (length) (depth to top)			
(5) screen (size) (material)			
(6) pump (HP) (yield gpm)			
(type power)			
(7) electric log (yes or no)			
(organization running log)			
(8) how well bottom plugged B.P. plug			
DRILLERS REMARKS: Pump installed by owner			

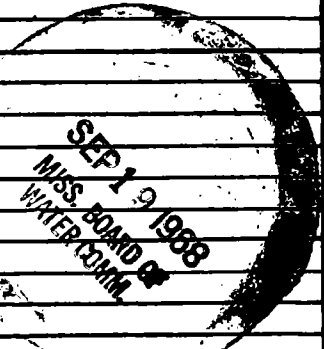

If well telescopes please sketch and show depths.

GROUND LEVEL

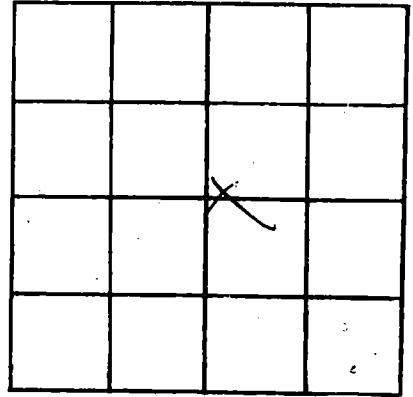

SECTION 17

Please indicate well location X.

ADDITIONAL INFORMATION

If more than one screen,  
show locations of each on sketch.