

Jackson
K 69
5-6-70

MISSISSIPPI
BOARD OF WATER COMMISSIONERS
416 North State Street
Jackson, Mississippi 39201

CODED

WATER WELL DRILLERS LOG

5-6 1970 Coast Water Well Service Jackson
date well completed firm name county well located

LANDOWNER: Charwater Licking Corp
Unchance, Miss

WELL LOCATION: 158
sec. 27 T. 6 R. 7
3 miles S.E. of Unchance
(distance) (direction) (nearest town)

WELL PURPOSE: Compa
(home, irrigation, municipal, industrial)

WELL COMPLETION DATA:

- (1) diameter (inches) 2"
- (2) total depth (feet) 1346'
- (3) static water level (feet) 73 ^{below} above top of ground.
- (4) casing galv. (material), 1326' (depth)
2" (size) If telescope see back.
- (5) screen 20' (length), 1326' (depth to top)
2" (size), Stainless Perlug (material)
- (6) pump — (HP), 45 (yield gpm)
none (type power)
- (7) electric log NO (yes or no)

(organization running log)

(8) how well bottom plugged Backfilled
Value

DRILLERS REMARKS:


Description of formations encountered	from	to
Clay	0	60
Loam	60	90
Clay	90	450
Loam gravel	450	550
Clay	550	900
Loam	900	930
Clay	930	1290
Fine sand	1290	1346

MAY 31 1970

MISS. BD OF WATER COMMISSIONERS

If well telescopes please sketch and show depths.

GROUND LEVEL

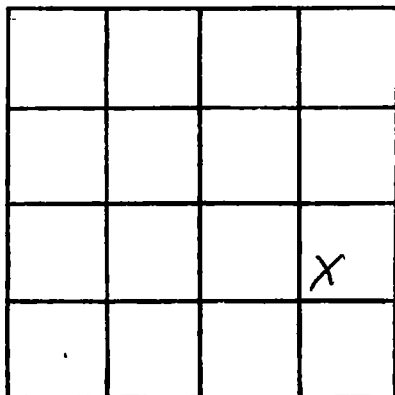

SECTION 27

Please indicate well location X.

ADDITIONAL INFORMATION

If more than one screen,
show locations of each on sketch.