

K 77

*can't locate*

**CODED**

WATER WELL DRILLERS LOG

4-7-64

3741

Date: 4-7, 1964, Driller: Hattisburg Butens County Jackson  
 (Name)

(1) Owner of Land: Wella Taylor  
 (Name)  
Darlene, Miss.  
 (Address)

(2) Location: 1/4, 1/4, Sec. 4 T6R7,  
 miles \_\_\_\_\_ of \_\_\_\_\_  
 (distance) (direction) (Nearest Town)

(3) Topography: X  
 (Hilly) (Flat) (Level)

(4) Purpose of Well: domestic  
 (Domestic Irrigation  
 Municipal, Industrial, Other)

Description & Color of Materials Sand, Clay, Red Clay, Shell, etc.	Thick- ness Feet	Depth Feet
<u>yellow clay</u>	<u>0-15</u>	
<u>white clay</u>	<u>15</u>	<u>50</u>
<u>yellow sand</u>	<u>50</u>	<u>110</u>
<u>Blue clay</u>	<u>110</u>	<u>258</u>
<u>Blue sand</u>	<u>258</u>	<u>272</u>

**CODED**

Information upon completion of well:

(1) Diameter 2 inches.

(2) Total Depth 272 feet.

(3) Water Level 33 feet below top of ground.

(4) Cased to \_\_\_\_\_, Size \_\_\_\_\_


(5) Screen: Size 2", Length 10'

(6) Were any formations sealed against pollution?  
 \_\_\_\_\_ yes, \_\_\_\_\_ no.

If YES depth of formation \_\_\_\_\_

Why \_\_\_\_\_

Drillers Remarks: \_\_\_\_\_

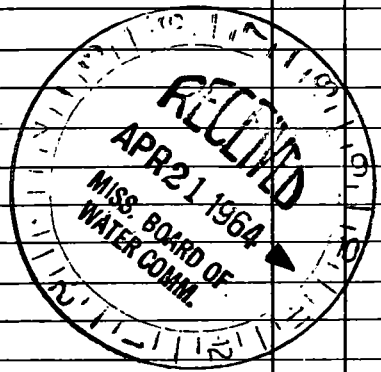

(Use Back Side)

Well No.

THE UNIVERSITY OF CHICAGO  
LIBRARY