

JACKSON

K 78

WATER WELL DRILLERS LOG

CODED

5-8-64

3798 C. I. SWITZER WELL CO.

Date: 5-8-64, 1964, Driller: [Signature], County: [Signature]

(Name)

(1) Owner of Land: C. I. Switzer  
(Name)

Van Levee, Miss. Hwy. 1000 Rd  
(Address)

(2) Location: 1/4, 1/4, Sec. 35 T 6 R 7  
(distance) (direction) (Nearest Town)

(3) Topography:  (Hilly)  (Flat)  (Level)

(4) Purpose of Well: Domestic  
(Domestic Irrigation, Municipal, Industrial, Other)

Description & Color of Materials Sand, Clay, Red Clay, Shell, etc.	Thick- ness Feet	Depth Feet
clay	10	12
sand	12	45
clay	45	45
light sand	75	91
sand	91	105
sand, gravel	105	126
sand	126	130
clay	130	152
sand	152	173
clay	173	215
sand, gravel	215	247
clay	247	328
sand, gravel	328	408
sand	408	420
sand & clay	420	430
clay w/ sand shls	430	450
shale	450	542
sand	542	556
shale	556	572
shale w/ sand shls	572	592
shale	592	612
fillers earth	612	633
lime sand & shale	633	693
shale	693	753
shale w/ sand shls	753	793
shale	793	841
sand	841	855
fine sand w/ shls	855	895
shale	895	972
sand	972	1058

Information upon completion of well:

(1) Diameter 2 1/2 inches.

(2) Total Depth 1058 feet.

(3) Water Level 15' + feet below top of ground.

(4) Cased to 1058', Size 3 x 2"

(5) Screen: Size 2", Length 30'


(6) Were any formations sealed against pollution?  
 yes,  no.

If YES depth of formation \_\_\_\_\_

Why North Dept. Requirement

Drillers Remarks: \_\_\_\_\_

CODED

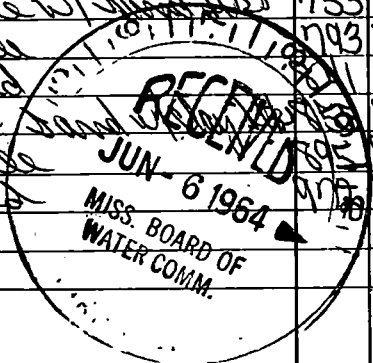

(Use Back Side)

Well No.

